

TUNICA
K 8
10-66

MISSISSIPPI BOARD OF WATER COMMISSIONERS

WATER WELL DRILLERS LOG

CODED

Date: Oct 8, 1966, Driller: Shelby Neyman County Franklin
(Name)

	Description & Color of Materials Sand, Clay, Red Clay, Shell, etc.	Thick- ness Feet	Depth Feet
(1) Owner of Land: <u>Jim Dutton</u> (Name)			
<u>Duende Miss</u> (Address)	<u>Black Clay</u>	<u>10</u>	<u>10</u>
(2) Location: <u>NE corner of lot 7 of the Pruette Subdivision</u> <u>1/4, 1/4, Sec. 14, T. 6 R. 11, meet</u>	<u>Sandy Soil</u>	<u>60</u>	<u>70</u>
<u>10 N East</u> of <u>Duende</u> (distance) (direction) (Nearest Town)	<u>Clear Sand</u>	<u>18</u>	<u>88</u>
(3) Topography: <u>Flat</u> (Hilly) (Flat) (Level)			
(4) Purpose of Well: <u>Domestic</u> (Domestic Irrigation Municipal, Industrial, Other)			

Information upon completion of well:


- (1) Diameter 2 inches.
- (2) Total Depth 88 feet.
- (3) Water Level 22 feet below top of ground.
- (4) Cased to 82, Size 2 in.
- (5) Screen: Size 90, Length 6 ft.
- (6) Were any formations sealed against pollution?

yes yes, _____ no.

If YES depth of formation Sand within 10 ft of surface

Why _____

Drillers Remarks: Location was taken from Deed of Land

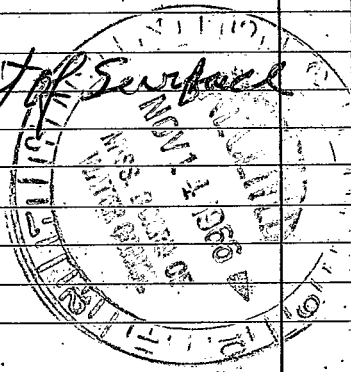

(Use Back Side)

Well No.

100
100 10