

①

TUNICA  
K 9  
6-68

MISSISSIPPI  
BOARD OF WATER COMMISSIONERS  
416 North State Street  
Jackson, Mississippi 39201

CODED

WATER WELL DRILLERS LOG

6/14/1968 date well completed  
ADEL WELL SUPPLY CO firm name  
TUNICA county well located

LANDOWNER: SCOTT A.

description of formations encountered

ARNOLD JR

from to  
Gumbo 1' 3'

TUNICA MISS (mailing address)

CLAY - SHALE 3' 15'

FINE SAND 15' 25'

COURSE SAND 25' 60'

WELL LOCATION:

COURSE SAND + HEAVY GRAVEL 60' 110'

sec 11 T 6 S R 11 W

Approx 3 miles E.N.E of DUBBS (distance) (direction) (nearest town)

WELL PURPOSE: IRRIGATION (home, irrigation, municipal, industrial)

WELL COMPLETION DATA:

(1) diameter (inches) 10"

(2) total depth (feet) 110'

(3) static water level (feet) 9' below top of ground.

(4) casing STEEL PIPE, 80' (material) (depth)

if telescope see back. (size)

(5) screen 30' length, 80' depth to top

10" size, SS WIRE WRAPPED (material)

(6) pump 120 (HP), 1400-1600 GPM (yield gpm)

100 LBS. PUMP (type power), PLANTER ENGINE, 6 YEAR DRIVE

(7) electric log NO (yes or no)

(organization running log)


(8) how well bottom plugged STEEL

DRILLERS REMARKS:

JUN 17 1968  
MISS. Bd. OF WATER CONTROL

If well telescopes please sketch and show depths.

GROUND LEVEL

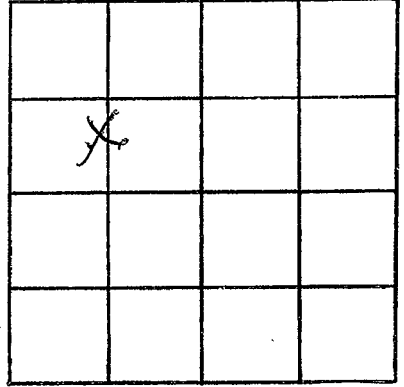

SECTION 11

Please indicate well location X.

ADDITIONAL INFORMATION

THESE WELLS TO BE USED  
FOR FARM IRRIGATION  
TO FURNISH WATER  
UNDER PRESSURE FOR  
VALLEY SELF PROPELLED  
SPRINKLER

If more than one screen,  
show locations of each on sketch.