

2

CODED

MISSISSIPPI
 BOARD OF WATER COMMISSIONERS
 416 North State Street
 Jackson, Mississippi 39201

WATER WELL DRILLERS LOG

TUNICA.
K10
6-68

6-14-1968 date well completed ABEL WELL SUPPLY CO. firm name TUNICA county well located

LANDOWNER: SCOTT A. ARNOLD JR.
 TUNICA MISS (mailing address)
 WELL LOCATION:
 sec. 11 T. 6 S. R. 11 W.
 approx. 3 1/2 miles E.N.E. of DUBAS
 (distance) (direction) (nearest town)

description of formations encountered	from	to
CLUMBO	1'	3'
CLAY-SHALE	3'	15'
FINE SAND	15'	25'
COARSE SAND	25'	60'
COARSE SAND - HEAVY GRAVEL	60'	110'

WELL PURPOSE: FERTIGATION
 (home, irrigation, municipal, industrial)

WELL COMPLETION DATA:

(1) diameter (inches) 10"

(2) total depth (feet) 110'

(3) static water level (feet) 10' below top of ground.

(4) casing STEEL (material), 80' (depth)
 if telescope see back.

(5) screen 30' (length), 80' (depth to top)
 10" (size), SS WIRE WRAPPED (material)

(6) pump 120 (HP), 1400-1600 (yield gpm)
 RA GEAR DRIVE BUTANE MOTOR AT 100 PSI
 (type power)

(7) electric log NO (yes or no)
 (organization running log)


(8) how well bottom plugged STEEL

MAY 17 1968
 MISS. Bd. OF WATER COMMISSIONERS

DRILLERS REMARKS:

If well telescopes please sketch and show depths.

GROUND LEVEL

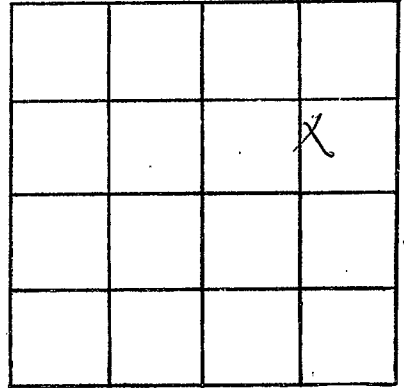

SECTION 11

Please indicate well location X.

ADDITIONAL INFORMATION

If more than one screen, show locations of each on sketch.