

3

TUNICA  
K 11  
6-68

MISSISSIPPI  
BOARD OF WATER COMMISSIONERS  
416 North State Street  
Jackson, Mississippi 39201

**CODED**

WATER WELL DRILLERS LOG

6-14-1968 date well completed      ABEL WELL SUPPLY Co. firm name      TUNICA county well located

LANDOWNER: SCOTT, A.  
ARNOLD JR.  
TUNICA MISS (mailing address)

description of formations encountered	from	to
CLAY	1"	3'
CLAY - SHALE	3'	15'
FINE SAND	15'	25'
COURSE SAND	25'	60'
COURSE SAND		
HEAVY GRAVEL	60'	110'

WELL LOCATION:  
sec. 12 T. 6 S. R. 11 W.  
Approx 7 1/2 miles (distance) EAST of DUBBS (nearest town)

WELL PURPOSE: IRRIGATION  
(home, irrigation, municipal, industrial)

**CODED**

WELL COMPLETION DATA:

(1) diameter (inches) 10"

(2) total depth (feet) 110'

(3) static water level (feet) 11' below top of ground.

(4) casing STEEL, 80' (material), (depth)

if telescope see back.  
(size)

(5) screen 30' 80' (length), (depth to top)

10" 55 WIRE WRAPS (size), (material)

(6) pump 120 1400-1600 GPM (yield gpm)  
RA. GEM DRILLS  
BETHANE 1/2 HP (type power)

(7) electric log NO (yes or no)

(organization running log)


(8) how well bottom plugged STEEL

DRILLERS REMARKS:

MAY 17 1968  
MISS. Bd. OF WATER COMMISSIONERS

If well telescopes please sketch and show depths.

GROUND LEVEL

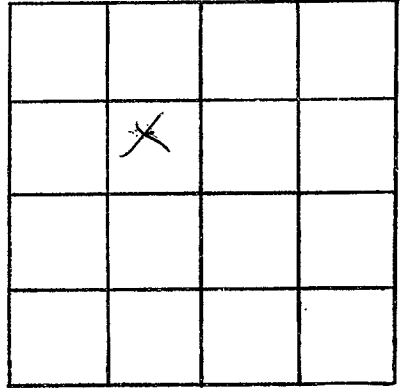

SECTION 12

Please indicate well location X.

ADDITIONAL INFORMATION

If more than one screen,  
show locations of each on sketch.