

Tunica.
 K5-12
 4-17-70

MISSISSIPPI
 BOARD OF WATER COMMISSIONERS
 416 North State Street
 Jackson, Mississippi 39201

CODED

WATER WELL DRILLERS LOG

4/17 - 1970 JH ABEL & SON, INC. Tunica
 date well completed firm name county well located

LANDOWNER: WILLY
GODDOLD FARMS
TUNICA MISS
 (mailing address)

description of formations encountered	from	to
CLAY	1'	12'
FINE SAND	12'	28'
MED. SAND	28'	36'
COURSE SAND	36'	48'

WELL LOCATION:
 sec. 14 T. 6 S. R. 11 E.
3 miles 30 of DEARBORN
 (distance) (direction) (nearest town)

WELL PURPOSE: FILL POND
 (home, irrigation, municipal, industrial)

WELL COMPLETION DATA:

(1) diameter (inches) 2"

(2) total depth (feet) 48

(3) static water level (feet) 12 below above top of ground.

(4) casing COAL PIPE, 42'
 (material) (depth)
2" if telescope see back.
 (size)

(5) screen 6', 42'
 (length) (depth to top)
2", BRASS GALVANIZED
 (size) (material)

(6) pump 1 1/2, 35 GPM
 (HP) (yield gpm)
ELECTRIC MOTOR
 (type power)

(7) electric log NO
 (yes or no)

(organization running log)

(8) how well bottom plugged STEEL POINT

CODED


APR 30 1970

DRILLERS REMARKS: WELL USED TO FILL POND MERGE TANK AND TO BRUSH FARM EQUIPMENT

MISS. BD. OF WATER COMMISSIONERS

If well telescopes please sketch and show depths.

GROUND LEVEL

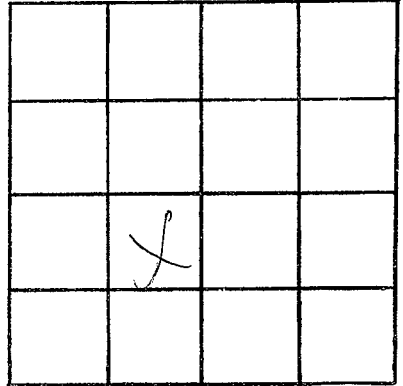

SECTION 14

Please indicate well location X.

ADDITIONAL INFORMATION

If more than one screen,
show locations of each on sketch.