

TUNICA  
K13  
1-4-75

MISSISSIPPI  
BOARD OF WATER COMMISSIONERS  
416 North State Street  
Jackson, Mississippi 39201

CODED CODED

WATER WELL DRILLERS LOG

1-4 date well completed      1975 Hester Drilling Co. firm name      Tunica county well located

LANDOWNER: <u>Edgar Hood III</u>	description of formations encountered	from	to
<u>Dunder Miss</u>			
	<u>fine sand</u>	<u>8</u>	<u>40</u>
(mailing address)	<u>coarse sand + gravel</u>	<u>40</u>	<u>103</u>

WELL LOCATION:  
sec. 32 T 6 N R 18 E <sup>15E</sup>  
4 miles east of Dunder  
(distance) (direction) (nearest town)

WELL PURPOSE:  
(home, irrigation, municipal, industrial)

- WELL COMPLETION DATA:
- (1) diameter (inches) 12"
  - (2) total depth (feet) 103'
  - (3) static water level (feet) 9 <sup>below</sup>/<sub>above</sub> top of ground.
  - (4) casing steel, 63  
(material) (depth)
  - 12 if telescope see back.  
(size)
  - (5) screen 40 ft, 63  
(length) (depth to top)
  - 12, steel  
(size) (material)
  - (6) pump 30 2000  
(HP) (yield gpm)
  - electric  
(type power)
  - (7) electric log no  
(yes or no)
  - (organization running log)
  - (8) how well bottom plugged steel pipe

DRILLERS REMARKS:

CODED CODED


DISCONTINUED FILE

MAR 10 1975

MISS. BD. OF WATER COMM

If well telescopes please sketch and show depths.

GROUND LEVEL

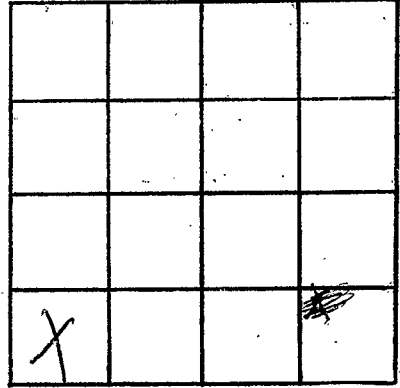

SECTION \_\_\_\_\_

Please indicate well location X.

ADDITIONAL INFORMATION

If more than one screen,  
show locations of each on sketch.