

TUNICA
K 14
4-10-76

MISSISSIPPI
BOARD OF WATER COMMISSIONERS CODED
416 North State Street
Jackson, Mississippi 39201

WATER WELL DRILLERS LOG

4-10 1976 Abster Drilling Co Tunica
date well completed firm name county well located

LANDOWNER: W.H. Hamrick
Tunica Miss
(mailing address)

description of formations encountered	from	to
Clay	0	23
fine sand	23	50
GRAVEL SAND	50	97

WELL LOCATION:
sec. 5 T. 6 N. R. 11 E
5 miles SE of TUNICA
(distance) (direction) (nearest town)

WELL PURPOSE: Domestic
(home, irrigation, municipal, industrial)

- WELL COMPLETION DATA:
- (1) diameter (inches) 12"
 - (2) total depth (feet) 97
 - (3) static water level (feet) 13 below top of ground
 - (4) casing steel, 57 (material) (depth)
12 if telescope see back. (size)
 - (5) screen 10, 57 (length) (depth to top)
12, steel (size) (material)
 - (6) pump 30, 2000 (HP) (yield gpm)
Electric (type power)
 - (7) electric log no (yes or no)

(organization running log)
(8) how well bottom plugged Plastic


DRILLERS REMARKS:

CODED

MAY - 8 1976

If well telescopes please sketch and show depths.

GROUND LEVEL

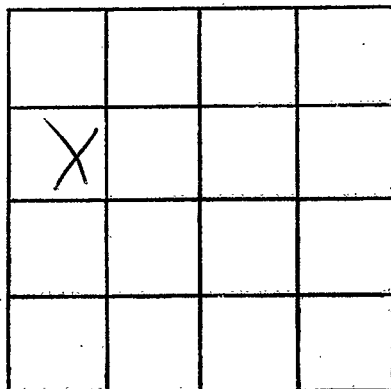

SECTION _____

Please indicate well location X.

ADDITIONAL INFORMATION

If more than one screen,
show locations of each on sketch.