

BOARD OF WATER COMMISSIONERS

416 North State Street

Jackson, Mississippi 39201

CODED

WATER WELL DRILLERS LOG

July 18 1978 Fine Co. Farm, Osan Lunice
 date well completed firm name county well located

LANDOWNER: W. H. Hudson
Lunice Min
 (mailing address)

WELL LOCATION:
 sec. 7 T. 6 N. R. 11 E. S. 5 W. 10
6 miles NORTH of Dundee
 (distance) (direction) (nearest town)

WELL PURPOSE: drinking
 (home, irrigation, municipal, industrial)

WELL COMPLETION DATA:

(1) diameter (inches) 14

(2) total depth (feet) 108

(3) static water level (feet) 18 below top of ground.

(4) casing Steel, 60' (material) (depth)
16" (size) if telescope see back.

(5) screen 48', 60' (length) (depth to top)
16, 50 S10T (size) (material)

(6) pump 40, 2000 (HP) (yield gpm)
diel (type power)

(7) electric log no (yes or no)

(organization running log)

(8) how well bottom plugged welded


description of formations encountered	from	to
top sand	0	10
fine sand	10	32
Coarse sand CODED	32	48
sand & pea	48	60
sand & pea	60	108

DRILLERS REMARKS:

RECEIVED

AUG 18 1978

GROUND LEVEL

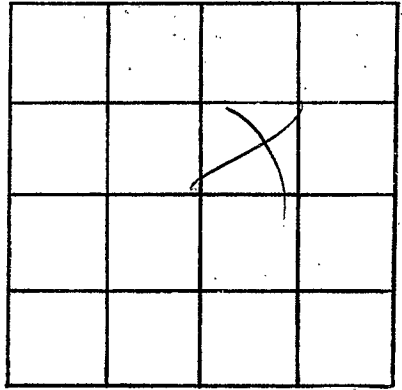

SECTION _____

Please indicate well location X.

ADDITIONAL INFORMATION

If more than one screen,
show locations of each on sketch.