

MISSISSIPPI DEPARTMENT OF NATURAL RESOURCES

Bureau of Land and Water Resources

Southport Mall

P.O. Box 10631

Jackson, Mississippi 39209

WATER WELL DRILLERS LOG

CODED

Tunica
K 18
51 181

MAY 19 81
date well completed

LEEPER Drilling
firm name


TUNICA
county well located

LANDOWNER:	description of formations encountered	from	to
Edgar Hood Jr Dundee, Ms (mailing address)			
WELL LOCATION:	fine sand	15	25
sec. 27 T 6 N R 11 W S	coarse sand and gravel	25	100
8 miles E of Dundee (distance) (direction) (nearest town)			
WELL PURPOSE: irrigation (home, irrigation, municipal, industrial)			
WELL COMPLETION DATA:			
(1) diameter (inches) 10			
(2) total depth (feet) 100			
(3) static water level (feet) 10 below top of ground.			
(4) casing PVC 60 (material) (depth)			
10 if telescope see back. (size)			
(5) screen 40 60 (length) (depth to top)			
10 PVC (size) (material)			
(6) pump 10 500 (HP) (yield gpm)			
electric (type power)			
(7) electric log (yes or no)			
(organization running log)			
(8) how well bottom plugged CAP			

DRILLERS REMARKS:

If well telescopes please sketch and show depths.

GROUND LEVEL

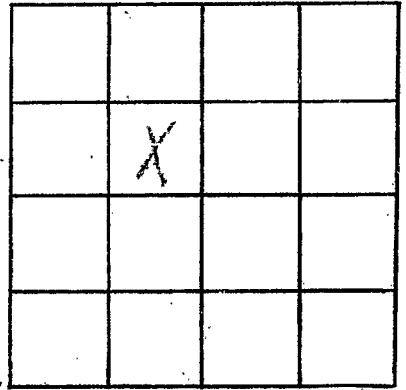

SECTION 27

Please indicate well location X.

ADDITIONAL INFORMATION

Lined area for additional information.

If more than one screen, show locations of each on sketch.

