

MISSISSIPPI DEPARTMENT OF NATURAL RESOURCES 3

Bureau of Land and Water Resources

Southport Mall

P.O. Box 10631

Jackson, Mississippi 39209

WATER WELL DRILLERS LOG

CODED

TUNICA
K 24
12-16-81

16 DEC 81 19 NORTH DELTA DRILLING TUNICA
 date well completed firm name county well located

LANDOWNER: ROY SMITH
 DUNDIE, MISS
 (mailing address)

description of formations encountered	from	to
CLAY	0	35
SAND	35	55
SAND & GRAVEL	55	105

WELL LOCATION:
 sec. 9 T. 65 S. R. 11 E
 1 miles NW of DUBBS
 (distance) (direction) (nearest town)

WELL PURPOSE: IRRIGATION
 (home, irrigation, municipal, industrial)

WELL COMPLETION DATA:

- (1) diameter (inches) 12"
- (2) total depth (feet) 105'
- (3) static water level (feet) 18' below above top of ground.
- (4) casing STEEL, 65' (material) (depth)
 12" (size) if telescope see back.
- (5) screen 40' (length), 65' (depth to top)
 12" (size), STEEL (material)
- (6) pump 80 (HP), 1450 (yield gpm)
 DIESEL (type power)
- (7) electric log NO (yes or no)
 (organization running log)
- (8) how well bottom plugged PLATE

CODED

DEPT OF NATURAL RESOURCES
 BUREAU OF LAND & WATER RESOURCES


JAN 4 1982

RECEIVED

DRILLERS REMARKS:

If well telescopes please sketch and show depths.

GROUND LEVEL

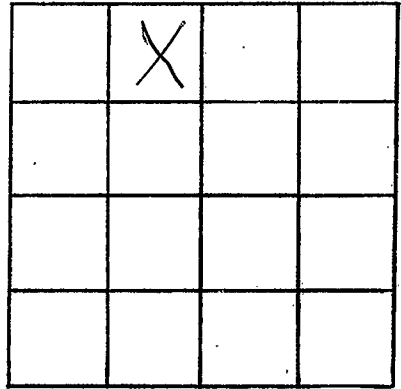

SECTION _____

Please indicate well location X.

ADDITIONAL INFORMATION

If more than one screen,
show locations of each on sketch.