

MISSISSIPPI DEPARTMENT OF NATURAL RESOURCES  
 Bureau of Land and Water Resources  
 Southport Mall  
 P.O. Box 10631  
 Jackson, Mississippi 39209  
**WATER WELL DRILLERS LOG**

**CODED**

TUNICA
K <del>25</del> 25
12-7-81

7 DEC 81 19 NORTH DELTA DRILLING TUNICA  
 date well completed firm name county well located

LANDOWNER: <u>RAY SMITH</u> <u>DUNDEE, MISS</u>  (mailing address)	description of formations encountered <u>CLAY</u> <u>SAND</u> <u>SAND + GRAVEL</u>	from	to
		<u>0</u>	<u>38</u>
		<u>38</u>	<u>60</u>
		<u>60</u>	<u>110</u>

WELL LOCATION:  
 sec. 10 T. 65N R. 11E  
1 miles NE of DUNDBS  
 (distance) (direction) (nearest town)

WELL PURPOSE:  
 (home, irrigation, municipal, industrial) **CODED**

WELL COMPLETION DATA:

(1) diameter (inches) 12"

(2) total depth (feet) 110'

(3) static water level (feet) 18' below above top of ground.

(4) casing STEEL, 70'  
 (material) (depth)  
12" if telescope see back.  
 (size)

(5) screen 40', 70'  
 (length) (depth to top)  
12", STEEL  
 (size) (material)

(6) pump 60, 1400  
 (HP) (yield gpm)  
 (type power)

(7) electric log NO  
 (yes or no)  
 (organization running log)

(8) how well bottom plugged PLATE

DEPT. OF NATURAL RESOURCES  
 BUREAU OF LAND & WATER RESOURCES


JAN 4 - 1982

DRILLERS REMARKS:

**RECEIVED**

If well telescopes please sketch and show depths.

GROUND LEVEL

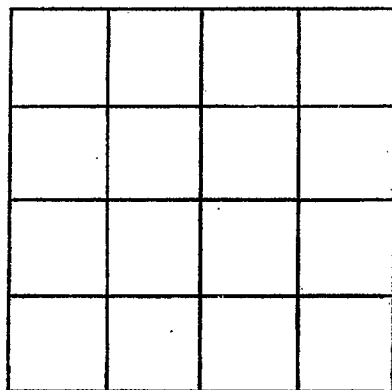

SECTION \_\_\_\_\_

Please indicate well location X.

ADDITIONAL INFORMATION

If more than one screen,  
show locations of each on sketch.