

TUNICA
K 27

MISSISSIPPI DEPARTMENT OF NATURAL RESOURCES
Bureau of Land and Water Resources
Southport Mall
P.O. Box 10631
Jackson, Mississippi 39209
WATER WELL DRILLERS LOG


CODED

3-25 1984 of Delta Well's Inrig. Tunica
date well completed firm name county well located

LANDOWNER:	description of formations encountered	from	to
Ray Smith	CLAY	0	50
Dubbs, Miss's (mailing address)	FINE SAND	50	65
WELL LOCATION: sec. 9 T 6 N R 11 E 6 miles S of Tunica (distance) (direction) (nearest town)	SAND & ROCKS	65	110
WELL PURPOSE: irrigation (home, irrigation, municipal, industrial)	CODED		
WELL COMPLETION DATA:			
(1) diameter (inches) 12"			
(2) total depth (feet) 110'			
(3) static water level (feet) 18' below top of ground.			
(4) casing steel, 110' (material) (depth) 12" (size) if telescope see back.			
(5) screen 40', 40' (length) (depth to top)			
12" (size), steel (material)			
(6) pump 70 (HP), 800 (yield gpm)			
Diesel (type power)			
(7) electric log (yes or no)	DEPT. OF NATURAL RESOURCES BUREAU OF LAND & WATER RESOURCES		
(organization running log)	SEP 19 1984		
(8) how well bottom plugged steel cap	RECEIVED		
DRILLERS REMARKS:			

If well telescopes please sketch and show depths.

GROUND LEVEL

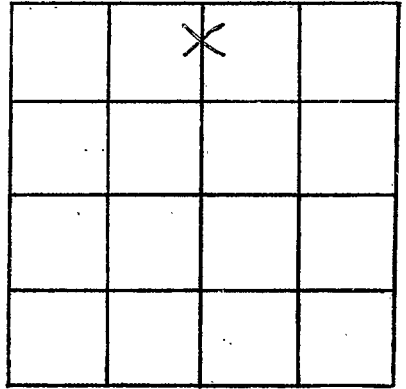

SECTION 9

Please indicate well location X.

ADDITIONAL INFORMATION

If more than one screen,
show locations of each on sketch.