

MISSISSIPPI DEPARTMENT OF NATURAL RESOURCES

Bureau of Land and Water Resources

Southport Mall

P.O. Box 10631

Jackson, Mississippi 39209

WATER WELL DRILLERS LOG

CODED

TUNICA
K29
Gw 2590

3-21-19 date well completed ST Delta Wells Tring firm name TUNICA county well located

LANDOWNER:	description of formations encountered	from	to
<u>Ray Smith</u>			
<u>Dubbs Miss</u> (mailing address)	<u>FINE SAND</u>	<u>50</u>	<u>62</u>
WELL LOCATION: sec. <u>16</u> T. <u>6</u> N. R. <u>11</u> E <u>7</u> miles <u>NE</u> of <u>TUNICA</u> (distance) (direction) (nearest town)	<u>COARSE SAND & ROCKS</u>	<u>62</u>	<u>110</u>
WELL PURPOSE: <u>irrigation</u> (home, irrigation, municipal, industrial)			
WELL COMPLETION DATA:			
(1) diameter (inches) <u>12"</u>			
(2) total depth (feet) <u>110'</u>			
(3) static water level (feet) <u>20</u> <u>Below</u> top of ground.			
(4) casing <u>Steel</u> , <u>110'</u> (material) (depth)			
<u>12"</u> (size) if telescope see back.			
(5) screen <u>40'</u> , <u>70'</u> (length) (depth to top)			
<u>12"</u> , <u>Steel</u> (size) (material)			
(6) pump <u>70</u> , <u>300</u> (HP) (yield gpm)			
<u>Diesel</u> (type power)			
(7) electric log _____ (yes or no)			
_____ (organization running log)			
(8) how well bottom plugged <u>Steel</u> <u>cap</u>			
DRILLERS REMARKS:			

CODED


DEPT. OF NATURAL RESOURCES
BUREAU OF LAND & WATER RESOURCES

SEP 19 1984

RECEIVED

If well telescopes please sketch and show depths.

GROUND LEVEL

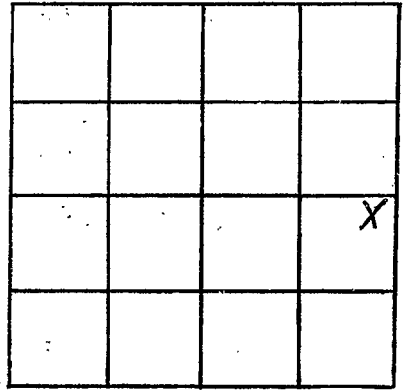

SECTION 16

Please indicate well location X.

ADDITIONAL INFORMATION

If more than one screen,
show locations of each on sketch.