

MISSISSIPPI DEPARTMENT OF NATURAL RESOURCES

Bureau of Land and Water Resources

Southport Mall

P.O. Box 10631

Jackson, Mississippi 39209

WATER WELL DRILLERS LOG

CODED

TUNICA
K 30

date well completed 3-20 1984 firm name Delta Well & Irrig county well located Tunica

LANDOWNER:	description of formations encountered	from	to
<u>Ray Smith</u> <u>Dubbs, Miss.</u> (mailing address)			
WELL LOCATION:	<u>FINE SAND</u>	<u>55</u>	<u>65</u>
sec. <u>16</u> T. <u>6</u> N. R. <u>11</u> E (S) (W)	<u>SAND &amp; Rocks</u>	<u>65</u>	<u>117</u>
<u>7</u> miles <u>SE</u> of <u>TUNICA</u> (distance) (direction) (nearest town)			
WELL PURPOSE: <u>irrigation</u> (home, irrigation, municipal, industrial)			
WELL COMPLETION DATA:			
(1) diameter (inches) <u>12"</u>			
(2) total depth (feet) <u>117'</u>			
(3) static water level (feet) <u>20</u> <sup>below</sup> / <sub>above</sub> top of ground.			
(4) casing <u>STEEL</u> , <u>117'</u> (material) (depth)			
<u>12"</u> (size) if telescope see back.			
(5) screen <u>40'</u> , <u>77'</u> (length) (depth to top)			
<u>12"</u> , <u>STEEL</u> (size) (material)			
(6) pump <u>30</u> <u>1000</u> (HP) (yield gpm)			
<u>DIESEL</u> (type power)			
(7) electric log (yes or no) _____  (organization running log) _____			
(8) how well bottom plugged <u>STEEL</u> <u>cap</u>			
DRILLERS REMARKS:			

CODED


DEPT. OF NATURAL RESOURCES  
BUREAU OF LAND & WATER RESOURCES

SEP 19 1984

RECEIVED

If well telescopes please sketch and show depths.

GROUND LEVEL

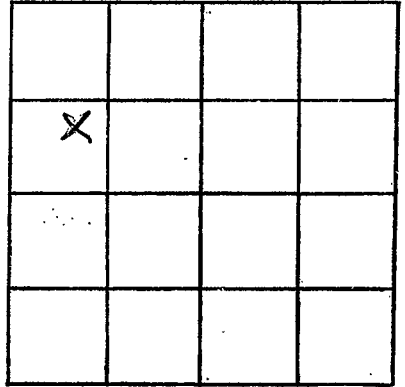

SECTION 16

Please indicate well location X.

ADDITIONAL INFORMATION

If more than one screen,  
show locations of each on sketch.