

MISSISSIPPI DEPARTMENT OF NATURAL RESOURCES

Bureau of Land and Water Resources

Southport Mall

P.O. Box 10631

Jackson, Mississippi 39209

WATER WELL DRILLERS LOG

CODED

| |
|--------|
| TUNICA |
| 1531 |
| |
| |

3-16-1984 of Delta Well & Irrig. Tunica
 date well completed firm name county well located

| LANDOWNER: | description of formations encountered | from | to |
|--|---------------------------------------|------|-----|
| RAY Smith | | | |
| Dubbs, Miss (mailing address) | FINE SAND | 40 | 55 |
| WELL LOCATION: sec. 4 T-6 N R-11 E 6 miles W S of TUNICA (distance) (direction) (nearest town) | SAND & ROCKS | 55 | 103 |
| WELL PURPOSE: <u>irrigation</u> (home, irrigation, municipal, industrial) | | | |
| WELL COMPLETION DATA: | | | |
| (1) diameter (inches) <u>12"</u> | | | |
| (2) total depth (feet) <u>103'</u> | | | |
| (3) static water level (feet) <u>18</u> <u>below</u> above top of ground. | | | |
| (4) casing <u>steel</u> <u>103'</u> (material) (depth) | | | |
| <u>12"</u> if telescope see back. (size) | | | |
| (5) screen <u>40'</u> <u>63'</u> (length) (depth to top) | | | |
| <u>12"</u> <u>steel</u> (size) (material) | | | |
| (6) pump <u>40</u> <u>800</u> (HP) (yield gpm) | | | |
| <u>DIESEL</u> (type power) | | | |
| (7) electric log (yes or no) _____ (organization running log) _____ | | | |
| (8) how well bottom plugged <u>steel</u> <u>CSP</u> | | | |
| DRILLERS REMARKS: | | | |

CODED


DEPT. OF NATURAL RESOURCES
 BUREAU OF LAND & WATER RESOURCES

SEP 19 1984

RECEIVED

If well telescopes please sketch and show depths.

GROUND LEVEL

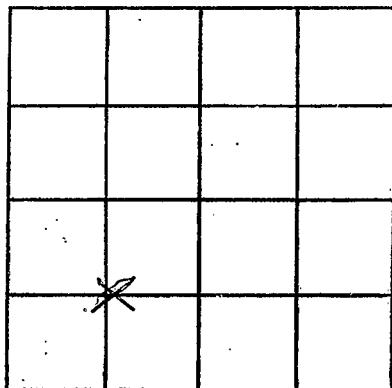

SECTION *f*

Please indicate well location X.

ADDITIONAL INFORMATION

If more than one screen,
show locations of each on sketch.