

MISSISSIPPI DEPARTMENT OF NATURAL RESOURCES

Bureau of Land and Water Resources

Southport Mall

P.O. Box 10631

Jackson, Mississippi 39209

WATER WELL DRILLERS LOG

CODED

TUNICA
K 32

3-15-84 date well completed Delta Wells Irrigation firm name Tunica county well located

LANDOWNER:	description of formations encountered	from	to
RAY Smith Dubbs, Miss. (mailing address)			
WELL LOCATION: sec. <u>4</u> T <u>6</u> N R <u>11</u> E <u>6</u> miles <u>S</u> of <u>TUNICA</u> (distance) (direction) (nearest town)	FINE SAND	48	55
WELL PURPOSE: <u>IRRIGATION</u> (home, irrigation, municipal, industrial)	COARSE SAND	55	65
WELL COMPLETION DATA: (1) diameter (inches) <u>12"</u> (2) total depth (feet) <u>103'</u> (3) static water level (feet) <u>18'</u> <u>below</u> above top of ground. (4) casing <u>Steel</u> , <u>103'</u> (material) (depth) <u>12"</u> If telescope see back. (size) (5) screen <u>40'</u> , <u>63'</u> (length) (depth to top) <u>12"</u> , <u>Steel</u> (size) (material) (6) pump <u>70</u> <u>800</u> (HP) (yield gpm) <u>DIESEL</u> (type power) (7) electric log _____ (yes or no) _____ (organization running log) (8) how well bottom plugged <u>Steel</u> <u>CAP</u>	SAND & ROCKS	65	103
DRILLERS REMARKS:			

CODED


DEPT. OF NATURAL RESOURCES
BUREAU OF LAND & WATER RESOURCES

SEP 19 1984

RECEIVED

If well telescopes please sketch and show depths.

GROUND LEVEL

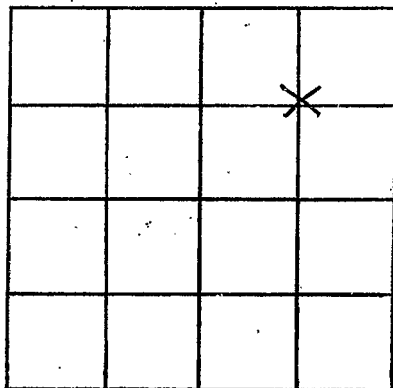

SECTION 4

Please indicate well location X.

ADDITIONAL INFORMATION

If more than one screen,
show locations of each on sketch.