

MISSISSIPPI DEPARTMENT OF NATURAL RESOURCES
 Bureau of Land and Water Resources
 Southport Mall
 P.O. Box 10631
 Jackson, Mississippi 39209
 WATER WELL DRILLERS LOG

CODED

TUNICA
 K33

3-13 1984 St Delta Well & Irrigation TUNICA
 date well completed firm name county well located

LANDOWNER: Ray Smith
 Dubbs Miss.
 (mailing address)

WELL LOCATION:
 sec. 3 T 6 N R 11 E
 6 miles S of TUNICA
 (distance) (direction) (nearest town)

WELL PURPOSE: IRRIGATION
 (home, irrigation, municipal, industrial)

WELL COMPLETION DATA:

(1) diameter (inches) 12"
 (2) total depth (feet) 110'
 (3) static water level (feet) 18' below above top of ground.
 (4) casing Steel 110' (material) (depth)
 (size) if telescope see back.
 (5) screen 40' 70' (length) (depth to top)
 12" steel (size) (material)
 (6) pump 70 1000 (HP) (yield gpm)
 DIESEL (type power)
 (7) electric log (yes or no)
 (organization running log)
 (8) how well bottom plugged STEEL CAP

description of formations encountered	from	to
CLAY	0	45
FINE SAND	45	55
COARSE SAND	55	80
SMALL GRAVEL	80	100
GRAVEL & ROCKS	100	110

CODED

DEPT. OF NATURAL RESOURCES
 BUREAU OF LAND & WATER RESOURCES


SEP 19 1984

RECEIVED

DRILLERS REMARKS:

If well telescopes please sketch and show depths.

GROUND LEVEL

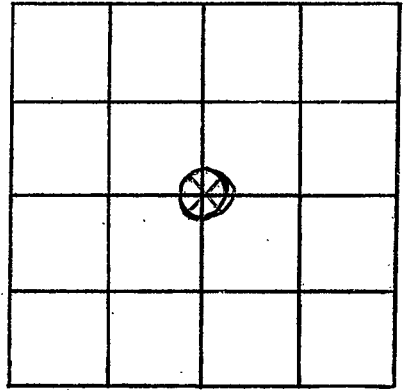

SECTION 3

Please indicate well location X.

ADDITIONAL INFORMATION

If more than one screen,
show locations of each on sketch.