• 4		
	WELL REPORT	
County: 1mn. 2A	Part 1	For Office Use Only:
Permit #: <u> GW: 47180</u> Mississippi Depart	Driller's Log ment of Environmental Quality	Well #: <u> </u>
Driller: Office of La	and and Water Resources	Aquifer:
lite drilling completed.	P.O. Box 2309 on, MS 39225-2309	E-Log #:
	(601)961-5210 1)360-0535 (fax)	
State Law requires that this report be prepared by the Department at the above address within 30 days of co.	ucense holder responsible for the molection of drilling of the well o	te work and filed with the r borehole.
Well Owner Information (Landowner if borehole is not for a water well)		hole Location
	Latitude: NBH J2 59.L184Lon	gitude: 190 22 19. 19. 1918
Owner Name: Moud Forms	Method of Lat/Long (check one)	
Mailing Address: Jushn Coriker	1	
1000 Mand Rd.	USGS quad, Hand-held GF	PS, Survey-grade GPS
Dunder, Mr. 38626	Ats 1/4 NW 1/4, Sec_	21- T 65 R 11W
City State Zip Code		andre
Telephone No. ()	(Distance) (Direction)	(Nearest Town)
Well (D	and the Deriv	
Date drilling started: <u>4-9-17</u> Date drilling completed:	orehole Data	
Location of the source of any surface water used for drillin	1	
Method of dosing and volume of Chlorine used in drilling a		
Logs run (circle all applicable). No log run Electric Gamm	na Ray Density Sonic Neutror	Other:
Name of organization running log(s):		
Purpose of borehole (circle one): Water Well Geotechnik	cal/Geological Investigation G	round Source Heat Pump
Seismic Survey Other (describe)	
If drilling is not related to water well construction, skip the remainder of this block		
Purpose of Well (circle all applicable): Home Industrial	Public Supply Irrigation Fi	sh Culture
Other (describe):		
If a flowing well, method of flow regulation: Valve	Other (describe)	
Static Water Level: <u>26</u> feet [above or below] land surface Date measured: <u>4-7-13</u> (circle one)		
Method of measurement (circle one): Steel tape Electric tape Air line Other (describe):		
Well depth: <u>120</u> Well grouted to a depth of: <u>10</u> feet Type of grout (circle one): Neat Cement, Bentonite Mix		
Casing length: <u>\$0</u> feet Casing diameter: <u>16</u> inches Type of casing: <u>PUL</u>		
Screen length: <u>40</u> feet Screen diameter: <u>16</u> inches Type of screen: <u>PUL</u>		
Screen slot size: <u>1032</u> inches Setting depth: From <u>\$0</u> feet to <u>120</u> feet		
Type of completion (circle all applicable). Gravel packed Underreamed Open hole Natural Development		
Other (describe):		<u>JUN 05-</u> 2013
Top of lap pipe or reduction in casing:feet		BY ON MA
If telescoped or more than o	ne screen, describe on next page	


Form:	OLWR	SWR-1A	(4/13)

ſ	z ,
ĺ	County: Taniza
	Permit #: <u>GW - 47180</u>

	Fo	r Office Use Only:
Well	#: _	K62
		-

The sketch below only required for water wells

If well telescopes, show depths on sketch.

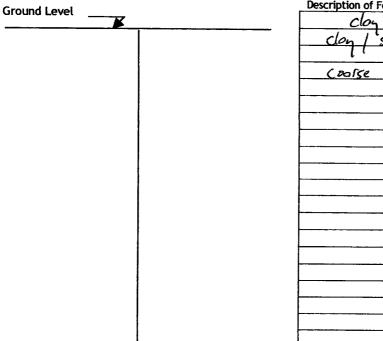

Description of formations encountered must be provided for all wells and boreholes, unless specifically exempted by regulations

From (depth)	To (depth)
Ground level	48
49	55
	•••••••••••••••••••••••••••••••••••••••
54	120
	49

If more than one screen, show location of each on sketch

Sketch the property layout and include the following: 1) the well location		
2) any permanent structures on the property that may aid in locating the well		
\mathcal{N} 3) any roads, power lines, or other items that may aid in locating the property and \mathcal{N} 4) north arrow	the well	
Dutbs la.		
billy legen		
in fac		
Norman and	:	
C · ·	RECEIVED	
~//	E Land Valley & V Rose had	
	JUN 05 2013	
ALL PI	BY: OLWR	
Alderson Kd.	But Bar Institute C. B.	
Landowner Name:		
I HEREBY CERTIFY that the well/borehole was drilled, constructed, and compl	eted in accordance with all applicable	
requirements of the Mississippi Department of Environmental Quality and the if applicable, and state laws.	Mississippi Department of Health regulations,	
Mr.3 Stall and size		
Print Name of Responsible Licensee and License No. Date	Signature of Liceosee	
	Form: OLWR-SWR-1A (4/13)	
	\sim	

•	STATE WELL REPORT	
County: Tun.2A	Part 2	
Permit #: 64 - 47 180	Pump Installer's Completion Report	For Office Use Only:
Driller: 250/	Mississippi Department of Environmental Quality	Well #:K62
Date completed: 4-9-13	Office of Land and Water Resources P.O. Box 2309	
	Jackson, MS 39225-2309	Aquifer:
Copy information from block on Part 1	(601)961-5210 (601) 360-0535 (fax)	
This part of the report must be completed	d by a licensed water well contractor or a licensed points filed with the Department at the above address	nump installer. A copy of Part 1
Well Owner Informati		Location
Owner Name: Mond Coms	Latitude: N 34 JZ 59 1	ongitude:190 22 19
Mailing Address: 1600 Mand L	0	
	5.	ne): Conventional Survey,
Judee Ms. 386	USGS quad, Hand-held	GPS, Survey-grade GPS
City Choke	$\frac{N\omega}{Zip Code} = \frac{N\omega}{2} \frac{N\omega}{4} \frac{N\omega}{4} \frac{N\omega}{4}$	= <u>21</u> T <u>65</u> R <u>11</u> W
	21p Code 3 Miles NE	of <u>Jundee</u> (Nearest Town)
Telephone No. ()	(Distance) (Direction)	(Nearest Town)
	Pump Type (circle one)	
Submersible Turbine Air Lift Centrifu	agal Flowing Well Jet Piston Rotary Other (describe):
	Rated Pump Capacity: 2	1
		Gallons Per Minute
Is This Pump (circle one): (New) Rep		
	Power Type (circle one)	
	Tractor PTO Windmill Other (<i>describe</i>):	
Horse Power Rating of Motor:	Setting Depth:feet Numb	er of Stages:
	Pump Test Data for Non Flowing Well	
Date Well Tested:	Duration of Pump Test (min	imum 4 hours): hours
	Below Land Surface Pumping Water Level (B):	
	Feet Below Land Surface Test Pumping Rate:	
Method of measurement (circle one): Ste	eel tape Electric tape Air line Other (describe)	:
	Pump Test Data for Flowing Well	
Measured shut in head:feet.		
Well yieldedGPM with a du	rawdown of feet after	hours of pumping
	Meter Installation	
Meter Manufacturer:		
	Type of Meter:	and the second second second
	ctor (AF x .001, gal x 1000, etc):	nc.,cv/ti
	Aeter installed by:	Market the second
Is This Meter (circle one): New Rep	·	
Important: By submitting the above inj For agricultur	formation you are certifying that this meter was ins all wells, a list of approved meters is on the MDEQ	talled to manufacturer standards. website.
	nents are true to the best of my knowledge.	nn n
Autor of the statem	ients are true to the best of my knowledge.	
Chris Shortday 200		1 hull
Print Name of Pump Installer and Licens	e No. (if applicable) Date Sig	nature of Pump Installer
		Form: OLWR-SWR-1B (4/13)