

MISSISSIPPI DEPARTMENT OF NATURAL RESOURCES

Bureau of Land and Water Resources

Southport Mall

P.O. Box 10631

Jackson, Mississippi 39209


WATER WELL DRILLERS LOG

TUNICA
K200

#1


3-13-1986 St Delta Well & Irrigation TUNICA A
date well completed firm name county well located

LANDOWNER: <u>Ray Smith</u>	description of formations encountered	from	to
<u>Dubbs Miss.</u> (mailing address)	CLAY	0	45
WELL LOCATION: sec. <u>3</u> T. <u>6</u> N. R. <u>11</u> E. <u>6</u> miles <u>SE</u> of <u>TUNICA</u> (distance) (direction) (nearest town)	FINE SAND	45	55
WELL PURPOSE: <u>IRRIGATION</u> (home, irrigation, municipal, industrial)	COARSE SAND	55	80
WELL COMPLETION DATA: (1) diameter (inches) <u>12"</u>	SMALL GRAVEL	80	100
(2) total depth (feet) <u>110'</u>	GRAVEL & ROCKS	100	110
(3) static water level (feet) <u>18</u> ^{below} above top of ground.			
(4) casing <u>STEEL</u> , <u>110'</u> (material) (depth)			
_____ If telescope see back. (size)			
(5) screen <u>40'</u> , <u>70'</u> (length) (depth to top)			
<u>12"</u> , <u>STEEL</u> (size) (material)			
(6) pump <u>70</u> , <u>1000</u> (HP) (yield gpm)			
<u>DIESEL</u> (type power)			
(7) electric log _____ (yes or no)			
_____ (organization running log)			
(8) how well bottom plugged <u>STEEL</u> <u>CAP</u>			
DRILLERS REMARKS:			

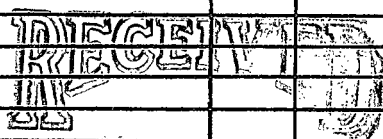

If well telescopes please sketch and show depths.

GROUND LEVEL

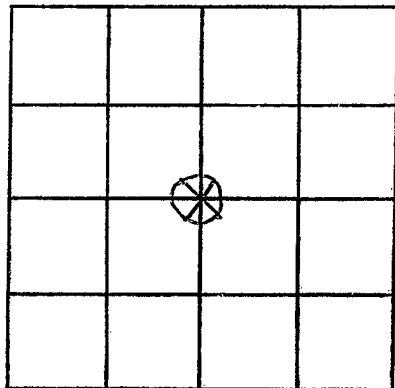

SECTION 3

Please indicate well location X.

ADDITIONAL INFORMATION

If more than one screen,
show locations of each on sketch.