

MISSISSIPPI DEPARTMENT OF NATURAL RESOURCES

Bureau of Land and Water Resources

Southport Mall

P.O. Box 10631

#2


Jackson, Mississippi 39209

WATER WELL DRILLERS LOG

Tunica
Kuba

3-15 1984 Delta Well's Irrigation Tunica
date well completed firm name county well located

LANDOWNER:	description of formations encountered	from	to
<u>RAY Smith</u> <u>Dubbs, Miss</u> (mailing address)			
WELL LOCATION: sec. <u>4</u> T. <u>6</u> N. R. <u>11</u> E. <u>6</u> miles <u>SE</u> of <u>TUNICA</u> (distance) (direction) (nearest town)	<u>FINE SAND</u>	<u>48</u>	<u>55</u>
WELL PURPOSE: <u>IRRIGATION</u> (home, irrigation, municipal, industrial)	<u>COARSE SAND</u>	<u>55</u>	<u>65</u>
WELL COMPLETION DATA: (1) diameter (inches) <u>12"</u> (2) total depth (feet) <u>103'</u> (3) static water level (feet) <u>18'</u> <u>below</u> above top of ground. (4) casing <u>STEEL</u> , <u>103'</u> (material) (depth) <u>12"</u> if telescope see back. (size) (5) screen <u>40'</u> , <u>63'</u> (length) (depth to top) <u>12"</u> , <u>STEEL</u> (size) (material) (6) pump <u>20</u> <u>800</u> (HP) (yield gpm) <u>DIESEL</u> (type power) (7) electric log _____ (yes or no) _____ (organization running log) (8) how well bottom plugged <u>STEEL</u> <u>CAP</u>	<u>SAND & ROCKS</u>	<u>65</u>	<u>103</u>
DRILLERS REMARKS:			

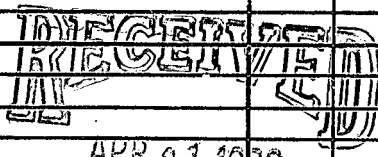


APR 21 1986

Department of Natural Resources
Bureau of Land & Water Resources

If well telescopes please sketch and show depths.

GROUND LEVEL

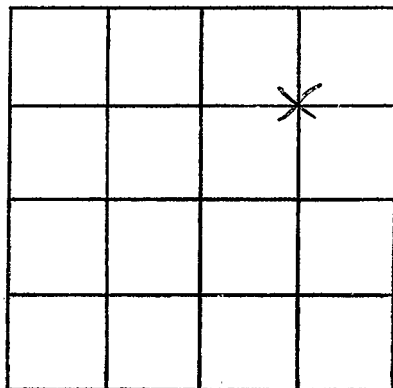

SECTION 4

Please indicate well location X.

ADDITIONAL INFORMATION

If more than one screen, show locations of each on sketch.