

MISSISSIPPI DEPARTMENT OF NATURAL RESOURCES

Bureau of Land and Water Resources

Southport Mall

P.O. Box 10631

Jackson, Mississippi 39209


WATER WELL DRILLERS LOG

3

TUNICA
K 2000


3-16 1984 Delta Well's Irrig. Tunica
date well completed firm name county well located

LANDOWNER:	description of formations encountered	from	to
RAY Smith	CLAY	0	40
Dubbs Miss (mailing address)	FINE SAND	40	55
WELL LOCATION: sec. 4 T-6 N R-11 E 6 miles SE of TUNICA (distance) (direction) (nearest town)	SAND & ROCKS	55	103
WELL PURPOSE: IRRIGATION (home, irrigation, municipal, industrial)			
WELL COMPLETION DATA:			
(1) diameter (inches) 12"			
(2) total depth (feet) 103'			
(3) static water level (feet) 18 below top of ground.			
(4) casing steel, 103' (material) (depth) 12" (size) if telescope see back.			
(5) screen 40' 60' (length) (depth to top) 12" steel (size) (material)			
(6) pump 40 800 (HP) (yield gpm) DIESEL (type power)			
(7) electric log (yes or no) (organization running log)			
(8) how well bottom plugged steel cap			
DRILLERS REMARKS:			

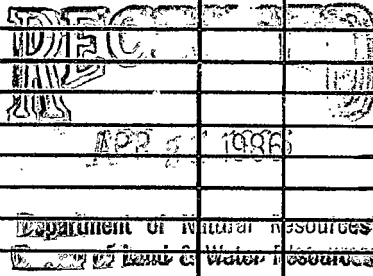

If well telescopes please sketch and show depths.

GROUND LEVEL

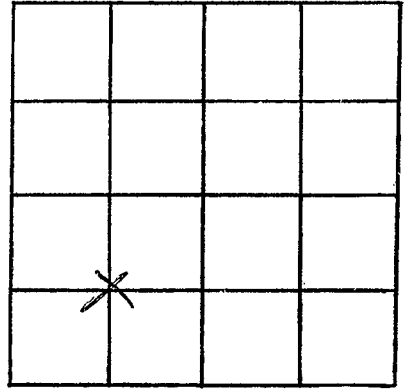

SECTION 4

Please indicate well location X.

ADDITIONAL INFORMATION

If more than one screen,
show locations of each on sketch.