


MISSISSIPPI DEPARTMENT OF NATURAL RESOURCES
 Bureau of Land and Water Resources
 Southport Mall
 P.O. Box 10631
 Jackson, Mississippi 39209
WATER WELL DRILLERS LOG

TUNICA
K2003

3-20 1984 date well completed Delta Well Drilling firm name Tunica county well located


LANDOWNER:	description of formations encountered	from	to
Ray Smith	CLAY	0	55
Dubois Miss (mailing address)	FINE SAND	55	65
WELL LOCATION: sec. <u>16</u> T- <u>6</u> N R- <u>11</u> E <u>7</u> miles (distance) <u>S</u> (direction) of <u>TUNICA</u> (nearest town)	SAND & ROCKS	65	117
WELL PURPOSE: <u>irrigation</u> (home, irrigation, municipal, industrial)			
WELL COMPLETION DATA:			
(1) diameter (inches) <u>12"</u>			
(2) total depth (feet) <u>117'</u>			
(3) static water level (feet) <u>20</u> <input checked="" type="checkbox"/> below <input type="checkbox"/> above top of ground.			
(4) casing <u>steel</u> , <u>117'</u> (material) (depth) <u>12"</u> (size) if telescope see back.			
(5) screen <u>40'</u> (length), <u>77'</u> (depth to top)			
(6) pump <u>30</u> (HP), <u>1000</u> (yield gpm) <u>DISTAL</u> (type power)			
(7) electric log <input type="checkbox"/> (yes or no)			
(organization running log)			
(8) how well bottom plugged <u>steel cap</u>			
DRILLERS REMARKS:			

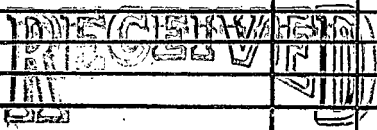

Department of Natural Resources
 Bureau of Land and Water Resources

If well telescopes please sketch and show depths.

GROUND LEVEL

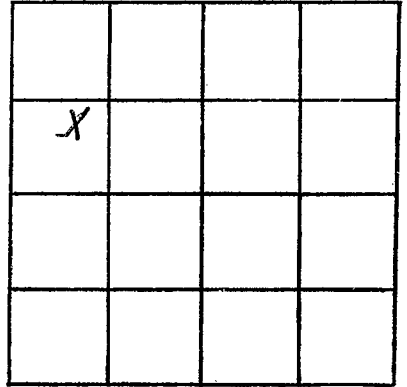

SECTION 16

Please indicate well location X.

ADDITIONAL INFORMATION

If more than one screen,
show locations of each on sketch.