

**MISSISSIPPI DEPARTMENT OF NATURAL RESOURCES**  
**Bureau of Land and Water Resources**  
 Southport Mall  
 P.O. Box 10631  
 Jackson, Mississippi 39209  
**WATER WELL DRILLERS LOG**

TUNICA  
Kearney

3-21-1984 DELA WELLS TRIG TUNICA  
 date well completed firm name county well located


LANDOWNER:	description of formations encountered	from	to
<u>Ray Smith</u> <u>Dubbs Miss</u> (mailing address)	<u>CLAY</u>	<u>0</u>	<u>50</u>
WELL LOCATION: sec. <u>16</u> T. <u>6</u> N. R. <u>11</u> E <u>7</u> miles <u>SE</u> of <u>Tunica</u> (distance) (direction) (nearest town)	<u>FINE SAND</u>	<u>50</u>	<u>62</u>
WELL PURPOSE: <u>irrigation</u> (home, irrigation, municipal, industrial)	<u>COARSE SAND &amp; ROCKS</u>	<u>62</u>	<u>110</u>
WELL COMPLETION DATA:			
(1) diameter (inches) <u>12"</u>			
(2) total depth (feet) <u>110'</u>			
(3) static water level (feet) <u>20</u> <input checked="" type="checkbox"/> below <input type="checkbox"/> above top of ground.			
(4) casing <u>Steel</u> , <u>110'</u> (material) (depth)			
<u>12"</u> (size) if telescope see back.			
(5) screen <u>40'</u> , <u>70'</u> (length) (depth to top)			
<u>12"</u> , <u>Steel</u> (size) (material)			
(6) pump <u>70</u> , <u>800</u> (HP) (yield gpm)			
<u>DIESEL</u> (type power)			
(7) electric log _____ (yes or no)			
_____ (organization running log)			
(8) how well bottom plugged <u>Steel</u> <u>cap</u>			
DRILLERS REMARKS:			
_____			
_____			
**RECEIVED**  
**APR 21 1986**

Res. 111/688  
 Res. 111/688  
 Department of Natural Resources  
 Bureau of Land & Water Resources

If well telescopes please sketch and show depths.

GROUND LEVEL

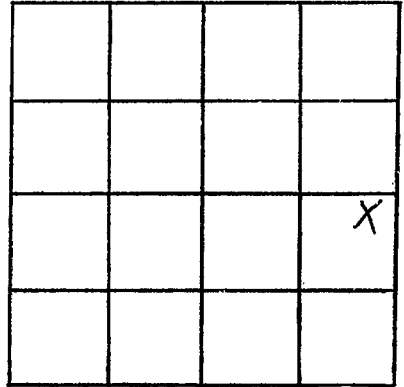

SECTION 16

Please indicate well location X.

ADDITIONAL INFORMATION

If more than one screen,  
show locations of each on sketch.