


MISSISSIPPI DEPARTMENT OF NATURAL RESOURCES
Bureau of Land and Water Resources
 Southport Mall
 P.O. Box 10631
 Jackson, Mississippi 39209
WATER WELL DRILLERS LOG

Tunica
K 2005

3-24 1984 Delta Well's Irrig Tunica
 date well completed firm name county well located

LANDOWNER:	description of formations encountered	from	to
<u>Ray Smith</u> <u>Dumas Miss.</u> (mailing address)			
WELL LOCATION:	<u>FINE SAND</u>	<u>45</u>	<u>60</u>
sec. <u>9</u> T. <u>6</u> N. R. <u>11</u> E. <u>6</u> miles (distance) <u>S</u> of <u>Tunica</u> (nearest town)	<u>SAND & ROCK</u>	<u>60</u>	<u>110</u>
WELL PURPOSE: <u>irrigation</u> (home, irrigation, municipal, industrial)			
WELL COMPLETION DATA:			
(1) diameter (inches) <u>12"</u>			
(2) total depth (feet) <u>110'</u>			
(3) static water level (feet) <u>18</u> <u>below</u> top of ground.			
(4) casing <u>Steel</u> <u>110'</u> (material) (depth)			
<u>12"</u> (size) if telescope see back.			
(5) screen <u>40'</u> <u>70'</u> (length) (depth to top)			
<u>12"</u> <u>Steel</u> (size) (material)			
(6) pump <u>70</u> <u>800</u> (HP) (yield gpm)			
<u>DIESEL</u> (type power)			
(7) electric log (yes or no) _____			
(organization running log) _____			
(8) how well bottom plugged <u>steel</u> <u>CAP</u>			
DRILLERS REMARKS:			

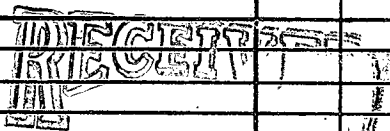


APR 27 1986

Department of Natural Resources
 Bureau of Land & Water Resources

If well telescopes please sketch and show depths.

GROUND LEVEL

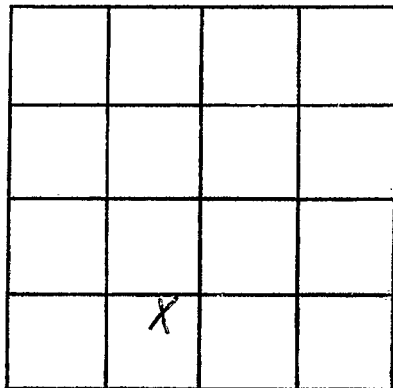

SECTION 9

Please indicate well location X.

ADDITIONAL INFORMATION

If more than one screen,
show locations of each on sketch.