

MISSISSIPPI DEPARTMENT OF NATURAL RESOURCES

Bureau of Land and Water Resources

Southport Mall

P.O. Box 10631

Jackson, Mississippi 39209

WATER WELL DRILLERS LOG

Tunica
Koser


3-25-19 of Delta Well & Irrig. Tunica
date well completed firm name county well located

LANDOWNER:	description of formations encountered	from	to
<u>Ray Smith</u>			
<u>Dubbs, Miss</u> (mailing address)	<u>FINE SAND</u>	<u>50</u>	<u>65</u>
WELL LOCATION:	<u>SAND & ROCKS</u>	<u>65</u>	<u>110</u>
sec. <u>9</u> T <u>6</u> N R. <u>11</u> E			
<u>6</u> miles <u>SE</u> of <u>Tunica</u> (distance) (direction) (nearest town)			
WELL PURPOSE: <u>irrigation</u> (home, irrigation, municipal, industrial)			
WELL COMPLETION DATA:			
(1) diameter (inches) <u>12"</u>			
(2) total depth (feet) <u>110'</u>			
(3) static water level (feet) <u>18'</u> <u>below</u> above top of ground.			
(4) casing <u>steel</u> , <u>110'</u> (material) (depth)			
<u>12"</u> (size) if telescope see back.			
(5) screen <u>40'</u> , <u>40'</u> (length) (depth to top)			
<u>12"</u> , <u>steel</u> (size) (material)			
(6) pump <u>40</u> <u>300</u> (HP) (yield gpm)			
<u>Direct</u> (type power)			
(7) electric log (yes or no) _____			
(organization running log) _____			
(8) how well bottom plugged <u>steel</u> <u>cap</u>			
DRILLERS REMARKS:			

RECEIVED
INDUSTRIAL
APR 21 1986
Department of Natural Resources
Bureau of Land & Water Resources

If well telescopes please sketch and show depths.

GROUND LEVEL

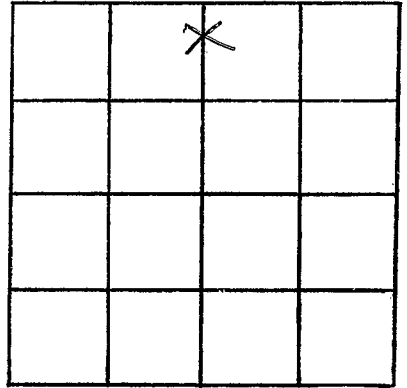

SECTION 9

Please indicate well location X.

ADDITIONAL INFORMATION

If more than one screen, show locations of each on sketch.