

TUNICA

MISSISSIPPI BOARD OF WATER COMMISSIONERS

2-20-65

WATER WELL DRILLERS LOG

CODED

Date: Feb 20, 1965, Driller: [Name] County: [County]

2515-19

(1) Owner of Land: [Name]

(Name)

[Address]

(Address)

(2) Location: 1/4, Sec. 9, T. 16, R. 10, E. 1, S. 10

1/4, Sec. 9, T. 16, R. 10, E. 1, S. 10

[distance] miles [direction], of [Nearest Town]

(3) Topography: [Hilly] [Flat] [Level]

(4) Purpose of Well: [Domestic Irrigation] [Municipal, Industrial, Other]

Information upon completion of well:

(1) Diameter [] inches.

(2) Total Depth [] feet.

(3) Water Level [] feet below top of ground.

(4) Cased to [] Size []

(5) Screen: Size [] Length []

(6) Were any formations sealed against pollution? [] yes, [] no.

If YES depth of formation []


Why []

Drillers Remarks: []

Description & Color of Materials Sand, Clay, Red Clay, Shell, etc.

Thickness Feet

CODED

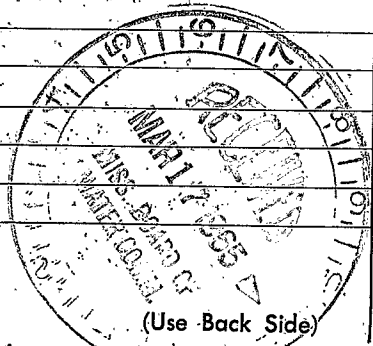

(Use Back Side)

Well No.

Mail this copy to Board of Water Commissioners 429 Miss. St. Jackson, Miss

