

TUNICA MISSISSIPPI BOARD OF WATER COMMISSIONERS

OL2

6-18-65

WATER WELL DRILLERS LOG

**CODED**

Date: June 18, 1965, Driller: Shelly Neyman County Tunica  
 (Name)  
1529-31

(1) Owner of Land: R. J. Mottley  
 (Name)  
Tunica Miss  
 (Address)

(2) Location: 1/4, 1/4, Sec. 28 29 T. 6 R. 10,  
12 miles South of Tunica  
 (distance) (direction) (Nearest Town)

(3) Topography: ✓  
 (Hilly) (Flat) (Level)

(4) Purpose of Well: ✓  
 (Domestic Irrigation, Municipal, Industrial, Other)

Description & Color of Materials Sand, Clay, Red Clay, Shell, etc.	Thick-ness Feet	Depth Feet
<u>Black clay</u>	<u>10</u>	
<u>Blue sand</u>	<u>50</u>	
<u>Blue clay</u>	<u>10</u>	
<u>Grey sand</u>	<u>22</u>	

Information upon completion of well:

(1) Diameter 2 inches.

(2) Total Depth 92 feet.

(3) Water Level 20 feet below top of ground.

(4) Cased to \_\_\_\_\_, Size \_\_\_\_\_

(5) Screen: Size 6 ft x 8 ft, Length 6 ft.


(6) Were any formations sealed against pollution?  
 \_\_\_\_\_ yes, ✓ no.

If YES depth of formation \_\_\_\_\_

Why \_\_\_\_\_

Drillers Remarks: \_\_\_\_\_

**CODED**

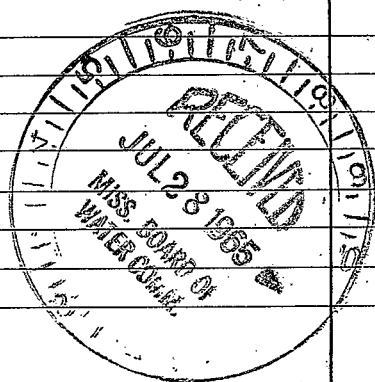

(Use Back Side)

Well No.

