

TUNICA
L3
6-7-73

MISSISSIPPI
BOARD OF WATER COMMISSIONERS
416 North State Street
Jackson, Mississippi 39201
WATER WELL DRILLERS LOG

CODED

6-7 1973 DYER WELL & IRRIGATION SERVICE TUNICA
date well completed firm name county well located

LANDOWNER: Corp of Engineers
MARKS
Miss.
(mailing address)

description of formations encountered	from	to
Clay	0	15
fine sand	15	40
Sand gravel	40	113

WELL LOCATION:
sec. 26 T. 6 S. R. 10 E.
2 miles S.W. of ASKEW
(distance) (direction) (nearest town)

WELL PURPOSE: RECREATION
(home, irrigation, municipal, industrial)

- WELL COMPLETION DATA:
- (1) diameter (inches) 16"
 - (2) total depth (feet) 113'
 - (3) static water level (feet) 14' below above top of ground.
 - (4) casing BERTR 16" (material) 73' (depth)
16" (size) If telescope see back.
 - (5) screen 40' 16" (length) 73' (depth to top)
16" (size) BER IN 60T (material)
 - (6) pump 50 (HP) 3000 (yield gpm)
DIESEL (type power)
 - (7) electric log No (yes or no)
 - (organization running log)
 - (8) how well bottom plugged PLATE

CODED

DRILLERS REMARKS:


OCT 20 1973

REC. RD. OF

If well telescopes please sketch and show depths.

GROUND LEVEL

ASKED REFUGEE

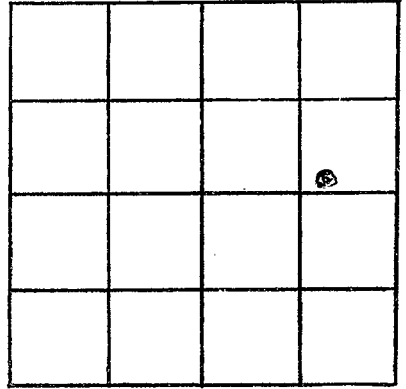

SECTION 26

Please indicate well location X.

ADDITIONAL INFORMATION

Multiple horizontal lines for entering additional information.

If more than one screen, show locations of each on sketch.