

TUNICA
L5
9-28-77

MISSISSIPPI
BOARD OF WATER COMMISSIONERS
416 North State Street
Jackson, Mississippi 39201

CODED

WATER WELL DRILLERS LOG

9-28 19 77 Aester Drilling Co. Tunica
date well completed firm name county well located

LANDOWNER: Paul Battle
Tunica Miss
(mailing address)

description of formations encountered	from	to
clay	0	29
fine sand	29	53
coarse sand gravel	53	103

WELL LOCATION:
sec 35 T 6 N R 10 E
miles of (distance) (direction) (nearest town)

WELL PURPOSE: Ind.
(home, irrigation, municipal, industrial)

- WELL COMPLETION DATA:
- (1) diameter (inches) 16"
 - (2) total depth (feet) 103
 - (3) static water level (feet) 26 below above top of ground.
 - (4) casing Steel 63
(material) (depth)
16" if telescope see back.
(size)
 - (5) screen 40' 63'
(length) (depth to top)
16" Steel
(size) (material)
 - (6) pump 60 3000
(HP) (yield gpm)
Dixie
(type power)
 - (7) electric log NO
(yes or no)
 - (8) how well bottom plugged plate

CODED


RECEIVED
NOV 10 1977

MISS. BD. OF WATER COMM

DRILLERS REMARKS:

If well telescopes please sketch and show depths.

GROUND LEVEL

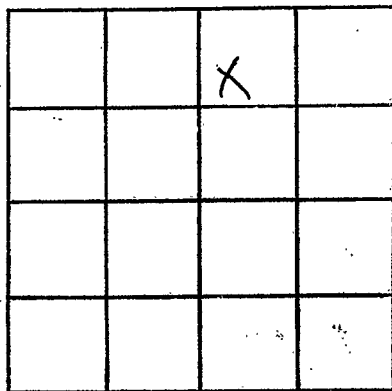

SECTION 6

Please indicate well location X.

ADDITIONAL INFORMATION

If more than one screen,
show locations of each on sketch.