

Jurica
L 7
4-5-81

MISSISSIPPI
BOARD OF WATER COMMISSIONERS
416 North State Street
Jackson, Mississippi 39201

CODED

WATER WELL DRILLERS LOG

4-5 1981 Hester Drilling Jurica
date well completed firm name county well located

LANDOWNER: Crenshaw Blvd
Crenshaw, Miss
description of formations encountered
from to
Gumbo clay 0 28
fine sand 38 66
Coarse sand + gravel 66 110
(mailing address)

WELL LOCATION: 6S
sec 25 T 7 N R 10 E
2 1/2 miles West of Crenshaw
(distance) (direction) (nearest town)

CODED

WELL PURPOSE: Irra
(home, irrigation, municipal, industrial)

- WELL COMPLETION DATA:
- (1) diameter (inches) 16
 - (2) total depth (feet) 110
 - (3) static water level (feet) 12 above top of ground.
 - (4) casing Steel 70
(material) (depth)
no if telescope see back.
(size)
 - (5) screen 40 70
(length) (depth to top)
16 Steel
(size) (material)
 - (6) pump 50 3000
(HP) (yield gpm)
Elet
(type power)
 - (7) electric log no
(yes or no)
no
(organization running log)
 - (8) how well bottom plugged Steel plate


DEPT. OF NATURAL RESOURCES
BUREAU OF LAND & WATER RESOURCES

RECEIVED
MAY - 7 1981

DRILLERS REMARKS: Was
Real good formation
battered out on rock

If well telescopes please sketch and show depths.

GROUND LEVEL

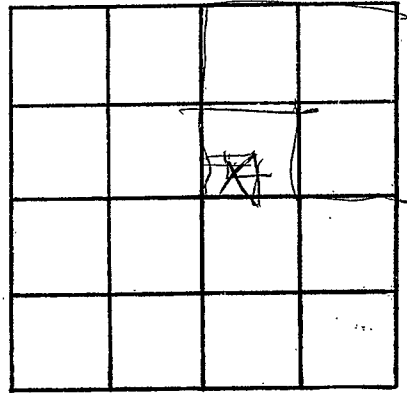

SECTION _____

Please indicate well location X.

ADDITIONAL INFORMATION

If more than one screen,
show locations of each on sketch.