

MISSISSIPPI DEPARTMENT OF NATURAL RESOURCES

Bureau of Land and Water Resources

Southport Mall

P.O. Box 10631

Jackson, Mississippi 39201

WATER WELL DRILLERS

CODED

Tunica
L 8
41 181

April 1981 LEEPER Drilling Tunica
 date well completed firm name county well located

LANDOWNER:
Milton Boyd
Dundee, Ms.
 (mailing address)

description of formations encountered

Top clay from 0 to 10
Five sand from 10 to 20

WELL LOCATION:
 sec. 19 T. 6 N. R. 10 W.
10 miles NE of LULA
 (distance) (direction) (nearest town)

COARSE sand and gravel from 20 to 100

WELL PURPOSE: irrigation
 (home, irrigation, municipal, industrial)

WELL COMPLETION DATA:

(1) diameter (inches) 12

(2) total depth (feet) 100

(3) static water level (feet) 10 below top of ground.

(4) casing PVC 60
 (material) (depth)

 if telescope see back.
 (size)

(5) screen 40 60
 (length) (depth to top)

12 PVC
 (size) (material)


(6) pump 40 2000
 (HP) (yield gpm)

Geachhead
 (type power)

(7) electric log NO
 (yes or no)

 (organization running log)


(8) how well bottom plugged CAP

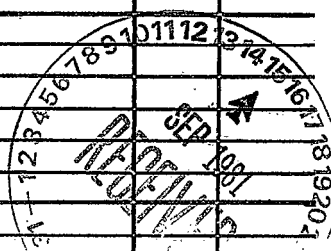

DRILLERS REMARKS:

If well telescopes please sketch and show depths.

GROUND LEVEL

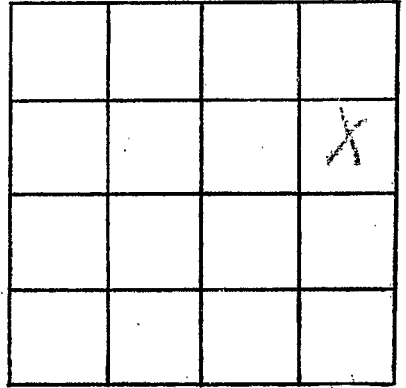

SECTION _____

Please indicate well location X.

ADDITIONAL INFORMATION

If more than one screen,
show locations of each on sketch.

