




If well telescopes please sketch and show depths.

GROUND LEVEL

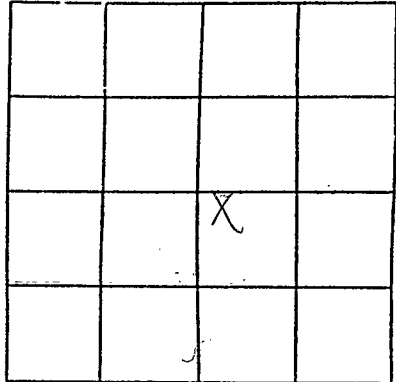

SECTION \_\_\_\_\_

Please indicate well location X.

Pump Capacity (GPM)	No. of Stages	Setting Depth	
3000	1	600	FT.

PUMP TEST

Well yielded 3000 GPM with a drawdown of 35 ft. after 2 hrs hours of pumping

LOG DATA

TYPE OF LOG RUN (Circle One): No Log Run.  
 Electric, Gamma Ray, Density, Sonic, Neutron, Other (Describe) \_\_\_\_\_

Name of Organization Running Log \_\_\_\_\_

GEOLOGIC DATA (Office Use Only)

Surface Elev.	Geologic Unit	Unit Thickness	Depth to Top
Subs. SWL	Date	Analysis	Aquifer Test

Driller's Remarks

\_\_\_\_\_

\_\_\_\_\_

If more than one screen, show location of each on sketch.