

TUNICA
 Jessica
 M 3.
 12-16-69

MISSISSIPPI
 BOARD OF WATER COMMISSIONERS
 416 North State Street
 Jackson, Mississippi 39201

CODED
 CODED

CODED

WATER WELL DRILLERS LOG

12-16-69 19
 date well completed

Price County Lumber
 firm name

Tunica
 Louisiana
 county well located

LANDOWNER: <u>B.T. Dobson</u> <u>Ruler, Miss.</u>	description of formations encountered	from	to
(mailing address)			
WELL LOCATION: sec. <u>26</u> T <u>7</u> N R <u>12</u> E <u>5</u> miles <u>N.E.</u> of <u>Ruler</u> (distance) (direction) (nearest town)	Clay	92	1259
WELL PURPOSE: <u>Home</u> (home, irrigation, municipal, industrial)	Gravel	1259	1274
WELL COMPLETION DATA:	Rocks	1274	1481
(1) diameter (inches) <u>2"</u>	Gravel	1708	1728
(2) total depth (feet) <u>1072</u>	Clay	1708	6617
(3) static water level (feet) _____ above top of ground.	Rocks	6617	6232
(4) casing <u>Black pipe, 1042</u> (material) (depth)	Rocks + Clay	6232	6449
<u>2"</u> if telescope see back. (size)	Clay	6449	6664
(5) screen <u>30'</u> , <u>1042</u> (length) (depth to top)	Sand	6664	7521
<u>2"</u> , <u>Stainless Steel</u> (size) (material)	Sand + Clay	7521	7745
(6) pump <u>1</u> , <u>1800</u> (HP) (yield gpm)	Sand	7745	9262
<u>Elec</u> (type power)	Clay	9262	10347
(7) electric log <u>no</u> (yes or no)	Sand	10347	10711
(organization running log)			
(8) how well bottom plugged <u>Wash</u> <u>Yam</u>			
DRILLERS REMARKS:			


CODED

JAN 8 1970

MISS. BD. OF
 WATER COMM.

If well telescopes please sketch and show depths.

GROUND LEVEL

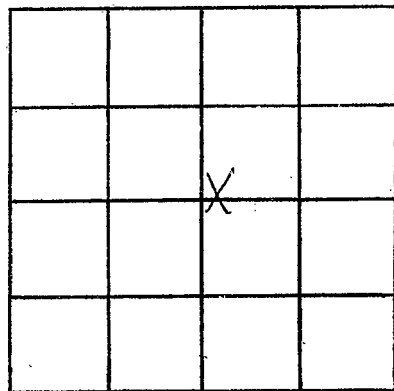

SECTION 26

Please indicate well location X.

ADDITIONAL INFORMATION

If more than one screen,
show locations of each on sketch.