

MISSISSIPPI DEPARTMENT OF NATURAL RESOURCES

Bureau of Land and Water Resources

Southport Mall

P.O. Box 10631

Jackson, Mississippi 39209

WATER WELL DRILLERS LOG

**CODED**

TUNICA
M 14
4   81

April 19 81 date well completed      LEEPER Drilling firm name      Tunica county well located

LANDOWNER: Chuck Austin #1  
Lula, Ms.  
 (mailing address)

WELL LOCATION:  
 sec. 2 T 7 S R. 12 W  
2 miles NE of LULA  
 (distance) (direction) (nearest town)

description of formations encountered	from	to
<u>Top clay</u>	<u>0</u>	<u>20</u>
<u>Thin sand</u>	<u>20</u>	<u>60</u>
<u>COARS and <del>gravel</del></u>	<u>60</u>	<u>118</u>

WELL PURPOSE: IRRIGATION  
 (home, irrigation, municipal, industrial)

WELL COMPLETION DATA:

(1) diameter (inches) 12"

(2) total depth (feet) 118

(3) static water level (feet) 18 below above top of ground.

(4) casing PVC 78'  
 (material) (depth)

\_\_\_\_\_ if telescope see back.  
 (size)

(5) screen 40' 78'  
 (length) (depth to top)

12" PVC  
 (size) (material)

(6) pump 50 2000  
 (HP) (yield gpm)

Electric  
 (type power)

(7) electric log NO  
 (yes or no)

\_\_\_\_\_ (organization running log)

(8) how well bottom plugged CAP

DRILLERS REMARKS:


DEPT. OF NATURAL RESOURCES  
 BUREAU OF LAND & WATER RESOURCES

SEP 16 1981

**RECEIVED**

If well telescopes please  
sketch and show depths.

GROUND LEVEL

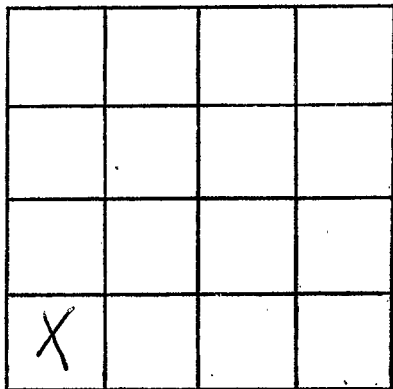

SECTION 2

Please indicate well location X.

ADDITIONAL INFORMATION

If more than one screen,  
show locations of each on sketch.