

MISSISSIPPI DEPARTMENT OF NATURAL RESOURCES

Bureau of Land and Water Resources

Southport Mall

P.O. Box 10631

Jackson, Mississippi 39201

WATER WELL DRILLERS LOG

**CODED**

TUNICA
M 15
41 181

April 19 81 date well completed *LEEPER Drilling* firm name TUNICA county well located

LANDOWNER:	description of formations encountered	from	to
Chuck Austin #2			
Lula MS - (mailing address)	Top clay FINE SAND	0 20	20 50
WELL LOCATION: sec. 2 T 7 N R 12 E S W 2 miles NE of Lula (distance) (direction) (nearest town)	CRACKED and pitted	50	110
WELL PURPOSE: <i>WELL FOR IRRIGATION</i> (home, irrigation, municipal, industrial)			
WELL COMPLETION DATA:			
(1) diameter (inches) 12"			
(2) total depth (feet) 110'			
(3) static water level (feet) 18' below top of ground.			
(4) casing PVC 70' (material) (depth)			
(size) if telescope see back.			
(5) screen 40' 70' (length) (depth to top)			
12" PVC (size) (material)			
(6) pump 50 2,000 (HP) (yield gpm)			
Gearhead (type power)			
(7) electric log NO (yes or no)			
(organization running log)			
(8) how well bottom plugged CAP			

DEPT. OF NATURAL RESOURCES  
BUREAU OF LAND & WATER RESOURCES


SEP 16 1981

**RECEIVED**

DRILLERS REMARKS:

If well telescopes please sketch and show depths.

GROUND LEVEL

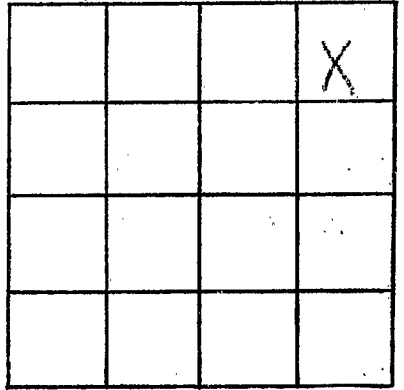

SECTION 2

Please indicate well location X.

ADDITIONAL INFORMATION

If more than one screen, show locations of each on sketch.