

TUNICA

~~BN~~ 5

10-5-64

WATER WELL DRILLERS LOG

**CODED**

Date: 10/5, 1964, Driller: Bailey W. Co. County: Washington  
 2323 (Name)

(1) Owner of Land	Description & Color of Materials Sand, Clay, Red Clay, Shell, etc.	Thick- ness Feet	Depth Feet
<u>Mr. D. Youngblood</u> (Name) <u>Andree, Miss.</u> (Address)	<u>Clay</u>		<u>30</u>
(2) Location: <u>1/4</u> , <u>1/4</u> , Sec. <u>16, 13, 20, 21</u> <u>T 7 R 11</u>	<u>Sand</u>		<u>85</u>
<u>1/4</u> miles <u>E</u> of <u>Andree</u> (distance) (direction) (Nearest Town)	<u>Gravel</u>		<u>110</u>
(3) Topography: <u>Flat</u> (Hilly) (Flat) (Level)	<u>Mud</u>		<u>266</u>
(4) Purpose of Well: <u>domestic</u> (Domestic Irrigation Municipal, Industrial, Other)	<u>Sand</u>		<u>350</u>
	<u>Mud + rocks</u>		<u>1475</u>
	<u>Sand</u>		<u>1578</u>

Information upon completion of well:

(1) Diameter 4 X 3 X 2 1/2 inches.

(2) Total Depth 1578 feet.

(3) Water Level 23 feet above below top of ground.

(4) Cased to all way, Size 4 X 3 X 2 1/2

(5) Screen: Size 2 1/2; Length 30 ft


(6) Were any formations sealed against pollution?  
 \_\_\_\_\_ yes, X no.

**CODED**

If YES depth of formation \_\_\_\_\_

Why \_\_\_\_\_

Drillers Remarks: \_\_\_\_\_

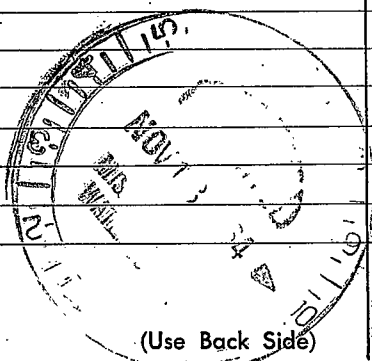

(Use Back Side)

Well No.

1000

1000