

Tunica Co
Nb

MISSISSIPPI
BOARD OF WATER COMMISSIONERS
416 North State Street
Jackson, Mississippi 39201

page 3
DEC - 1


WATER WELL DRILLERS LOG

date well completed 19 _____ firm name _____ county well located MISS. PD. OF W.

LANDOWNER:	description of fomations encountered	from	to
Dundee Water Ass'n			
Dundee, Miss	Sand	1600	1620
(mailing address)	sand	1620	1640
WELL LOCATION:	Sand	1640	1660
sec. _____ T _____ N _____ R _____ E _____ S _____ W _____	Sand	1660	1680
_____ miles _____ of _____ (distance) (direction) (nearest town)			
WELL PURPOSE: (home, irrigation, municipal, industrial)			
WELL COMPLETION DATA:			
(1) diameter (inches) _____			
(2) total depth (feet) _____			
(3) static water level (feet) _____ below above top of ground.			
(4) casing _____ (material) _____ (depth) _____ _____ (size) if telescope see back.			
(5) screen _____ (length) _____ (depth to top) _____ _____ (size) _____ (material)			
(6) pump _____ (HP) _____ (yield gpm) _____ _____ (type power)			
(7) electric log _____ (yes or no) _____ _____ (organization running log)			
(8) how well bottom plugged _____			
DRILLERS REMARKS:			

If well telescopes please sketch and show depths.

GROUND LEVEL

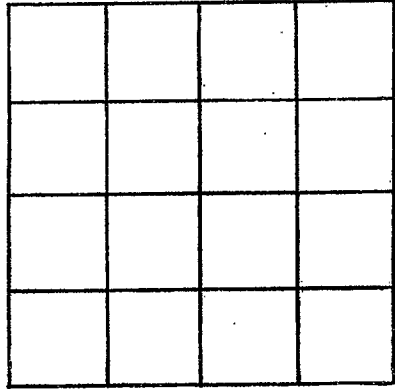

SECTION _____

Please indicate well location X.

ADDITIONAL INFORMATION

If more than one screen, show locations of each on sketch.