

Junica
N 8
4-17-75

MISSISSIPPI
 BOARD OF WATER COMMISSIONERS
 416 North State Street
 Jackson, Mississippi 39201

WATER WELL DRILLERS LOG

CODED

Singer-Rayne
Howze Planting Co.

Junica
Quitman

April 17, 1975
 date well completed

firm name

county well located

LANDOWNER: <u>Howze Planting Co.</u>	description of formations encountered	from	to
P. O. Box 85 Sledge, Miss. (mailing address)			
	Clay	0	20
	Medium Sand	20	52
	Coarse Sand & Gravel		
	Rock-cemented	52	107
WELL LOCATION: <u>11</u> sec. <u>12</u> T. <u>7</u> N. R. <u>10</u> E. (distance) (direction) (nearest town) <u>5</u> miles West of Sledge (distance) (direction) (nearest town)			
WELL PURPOSE: <u>irrigation</u> (home, irrigation, municipal, industrial)			
WELL COMPLETION DATA:			
(1) diameter (inches) <u>12"</u>			
(2) total depth (feet) <u>107'</u>			
(3) static water level (feet) <u>12</u> below top of ground.			
(4) casing <u>Steel</u> , <u>57'</u> (material) (depth) <u>12"</u> if telescope see back. (size)			
(5) screen <u>50'</u> , <u>50'</u> (length) (depth to top) <u>12"</u> , <u>Steel</u> (size) (material)			
(6) pump <u>60</u> , <u>1,800</u> (HP) (yield gpm) <u>engine</u> (type power)			
(7) electric log <u>no</u> (yes or no) <u>(organization running log)</u>			
(8) how well bottom plugged <u>steel plate</u>			
DRILLERS REMARKS:			


CODED

RECEIVED
 JUL 14 1975

MISS. BD. OF WATER COMMISSIONERS

If well telescopes please sketch and show depths.

GROUND LEVEL

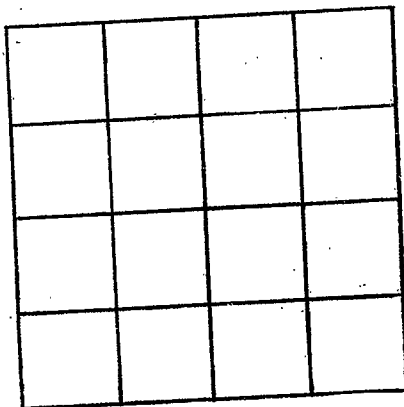

SECTION _____

Please indicate well location X.

ADDITIONAL INFORMATION

Lined area for additional information.

If more than one screen, show locations of each on sketch.