

TUNICA
N 9
10-2-76

MISSISSIPPI
BOARD OF WATER COMMISSIONERS
416 North State Street
Jackson, Mississippi 39201

CODED

WATER WELL DRILLERS LOG

10-2 1976 Horton Drilling Co. Tunica
date well completed firm name county well located

LANDOWNER: <u>Ranson Myers</u>	description of formations encountered	from	to
<u>TUNICA MISS</u>			
	<u>clay</u>	<u>0</u>	<u>18</u>
	<u>fine sand</u>	<u>18</u>	<u>48</u>
	<u>fine sand & gravel</u>	<u>48</u>	<u>100</u>

(mailing address)

WELL LOCATION:
sec. S 7 T. 7 N. R. 10 E.
6 miles SE of Dunderberg
(distance) (direction) (nearest town)

WELL PURPOSE:
(home, irrigation, municipal, industrial)

- WELL COMPLETION DATA:
- (1) diameter (inches) 16"
 - (2) total depth (feet) 100
 - (3) static water level (feet) 14 below/above top of ground.
 - (4) casing steel, 60,
(material) (depth)
16" if telescope see back.
(size)
 - (5) screen 40ft., 60ft.
(length) (depth to top)
16", steel
(size) (material)
 - (6) pump 100 3000
(HP) (yield gpm)
Direct
(type power)
 - (7) electric log no
(yes or no)

CODED

(organization running log)

(8) how well bottom plugged Plastic


DRILLERS REMARKS:

RECEIVED
NOV - 1 1976

MISS. BD. OF WATER COMMISSIONERS

If well telescopes please sketch and show depths.

GROUND LEVEL

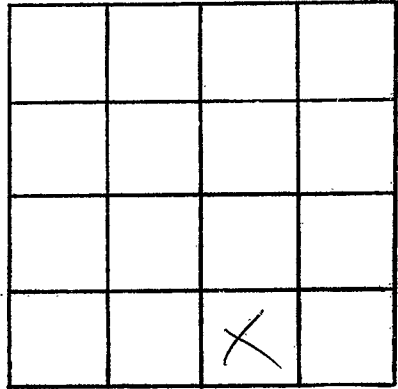

SECTION 5

Please indicate well location X.

ADDITIONAL INFORMATION

If more than one screen,
show locations of each on sketch.