

TUNICA
N 10
10-7-76

MISSISSIPPI
BOARD OF WATER COMMISSIONERS
416 North State Street
Jackson, Mississippi 39201

CODED

WATER WELL DRILLERS LOG

10-7 1976 Hester Drilling Co. Tunica
date well completed firm name county well located

LANDOWNER: <u>Cherry Farms</u>	description of formations encountered	from	to
<u>Sledge Miss</u>			
(mailing address)	<u>fine sand</u>	<u>12</u>	<u>45</u>
	<u>coarser sand gravel</u>	<u>45</u>	<u>95</u>

WELL LOCATION:
sec. 22 T. 7 N. R. 20 E.
2 miles West of LIBBS
(distance) (direction) (nearest town)

WELL PURPOSE: LIVESTOCK
(home, irrigation, municipal, industrial)

- WELL COMPLETION DATA:
- (1) diameter (inches) 6
 - (2) total depth (feet) 95
 - (3) static water level (feet) 11 below/above top of ground.
 - (4) casing steel, 55,
(material) (depth)
6 if telescope see back.
(size)
 - (5) screen 4 1/2, 55
(length) (depth to top)
6, steel
(size) (material)
 - (6) pump 10 1000
(HP) (yield gpm)
reactive
(type power)
 - (7) electric log no
(yes or no)

(organization running log)
(8) how well bottom plugged Plata

DRILLERS REMARKS:


CODED

RECEIVED

NOV - 1 1976

If well telescopes please sketch and show depths.

GROUND LEVEL

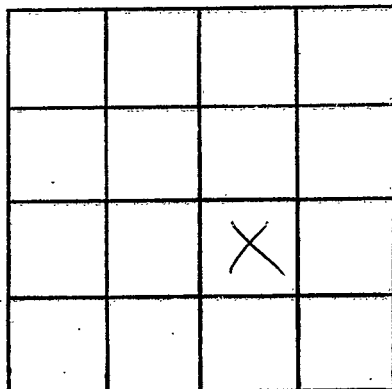

SECTION 22

Please indicate well location X.

ADDITIONAL INFORMATION

If more than one screen,
show locations of each on sketch.