

TUNICA
 W N II
 8-23-78

MISSISSIPPI
 BOARD OF WATER COMMISSIONERS CODED
 416 North State Street
 Jackson, Mississippi 39201

WATER WELL DRILLERS LOG

8-23 1978 Hester Drilling Tunica
 date well completed firm name county well located

LANDOWNER: Ransom
 Myers Farms
 Alvinde, Miss
 (mailing address)

description of formations encountered	from	to
Clay	0	10
Hard sand	10	48
Coarse sand & gravel	48	97

WELL LOCATION:
 sec. 5 T 7 N R 10 E
 5 miles South of Alvinde
 (distance) (direction) (nearest town)

WELL PURPOSE: Trk A.
 (home, irrigation, municipal, industrial)

- WELL COMPLETION DATA:
- (1) diameter (inches) 12 in
 - (2) total depth (feet) 97
 - (3) static water level (feet) 15 below top of ground
 - (4) casing Steel, 57 (material) (depth)
 - (size) If telescope see back.
 - (5) screen 40 in, 57 (length) (depth to top)
 - 12 in, Steel (size) (material)
 - (6) pump 30 (HP) 2000 (yield gpm)
 - D.C. (type power)
 - (7) electric log NO (yes or no)
 - (organization running log)
 - (8) how well bottom plugged Steel plug


DRILLERS REMARKS:

CODED

RECEIVED
 SEP 15 1978
 MISS. BD. OF WATER COMMISSIONERS

If well telescopes please sketch and show depths.

GROUND LEVEL

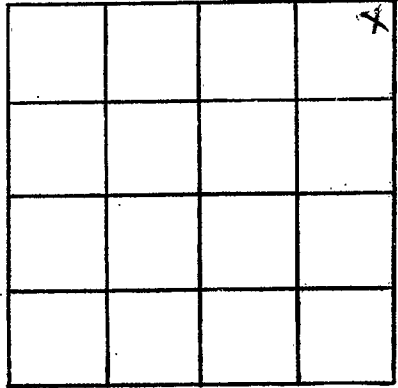

SECTION 5

Please indicate well location X.

ADDITIONAL INFORMATION

If more than one screen, show locations of each on sketch.