

TUNICA
N 12
8-21-78

MISSISSIPPI
BOARD OF WATER COMMISSIONERS
416 North State Street
Jackson, Mississippi 39201

CODED

WATER WELL DRILLERS LOG

8-21-78 date well completed
Hester Drilling firm name
Tunica county well located

LANDOWNER: William
McCintock Farms
Tunica, Miss.
(mailing address)

description of formations encountered	from	to
CLAY & Gumbo	0	20
Gumbo	20	45
FINE SAND	45	50
COARSE SAND & GRAVEL	50	103

WELL LOCATION:
sec 19 T 7 N R 11 E
10 miles West of Mound
(distance) (direction) (nearest town)

WELL PURPOSE: Irrig.
(home, irrigation, municipal, industrial)

- WELL COMPLETION DATA:
- (1) diameter (inches) 16
 - (2) total depth (feet) 103
 - (3) static water level (feet) 12 below top of ground.
 - (4) casing Steel 63 (material) (depth)
 - (5) screen 16 63 (length) (depth to top)
 - (6) pump 60 3000 (HP) (yield gpm)
 - (7) electric log NO (yes or no)

(organization running log)
(8) how well bottom plugged Steel plug

DRILLERS REMARKS:

CODED


RECEIVED

SEP 15 1978

MISS. BD. OF WATER COMM

If well telescopes please sketch and show depths.

GROUND LEVEL

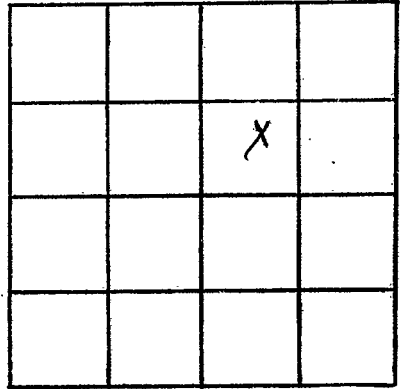

SECTION 19

Please indicate well location X.

ADDITIONAL INFORMATION

If more than one screen,
show locations of each on sketch.