

TUNICA
 N13
 4-25-80

MISSISSIPPI
 BOARD OF WATER COMMISSIONERS
 416 North State Street
 Jackson, Mississippi 39201

WATER WELL DRILLERS LOG

CODED

4-25-1980 date well completed, 20 Haster Drilling firm name, Tunica county well located

LANDOWNER: <u>WD GERRITT</u> <u>DUNDRE MS</u>	description of formations encountered	from	to
(mailing address)	clay fine sand coarse sand & gravel	0 25 65	25 65 110
WELL LOCATION: sec. <u>14</u> T. <u>7</u> N. R. <u>11</u> E. <u>2</u> miles <u>NW</u> of <u>T. 1335</u> (distance) (direction) (nearest town)			
WELL PURPOSE: <u>Irrigation</u> (home, irrigation, municipal, industrial)			
WELL COMPLETION DATA:			
(1) diameter (inches) <u>12</u>			
(2) total depth (feet) <u>110</u>			
(3) static water level (feet) <u>14</u> below/above top of ground			
(4) casing <u>steel</u> , <u>70'</u> (material) (depth)			
<u>12</u> if telescope see back. (size)			
(5) screen <u>40</u> , <u>70'</u> (length) (depth to top)			
<u>12</u> , <u>steel</u> (size) (material)			
(6) pump <u>30</u> , <u>2000</u> (HP) (yield gpm)			
<u>electric</u> (type power)			
(7) electric log <u>NO</u> (yes or no)			
(organization running log)			
(8) how well bottom plugged <u>plastic</u>			
DRILLERS REMARKS:			


CODED

DEPT. OF NATURAL RESOURCES
 BUREAU OF LAND & WATER RESOURCES

MAY 2
 RECEIVED

If well telescopes please sketch and show depths.

GROUND LEVEL

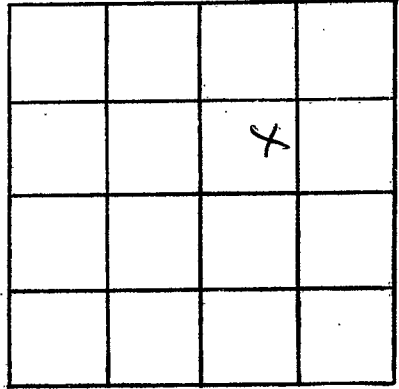

SECTION _____

Please indicate well location X.

ADDITIONAL INFORMATION

If more than one screen, show locations of each on sketch.