

TUNICA

N 20

8-23-80

8-23

1980

Kreston Drilling & Trench

CODED

MISSISSIPPI BOARD OF WATER COMMISSIONERS
416 North State Street
Jackson, Mississippi 39201

WATER WELL DRILLERS LOG

date well completed

firm name

county well located

LANDOWNER: Ransom Myres

description of formations encountered

from to

DUNDRE MS

Clay
fin sand
band gravel

0' 12'
12' 40'
40' 97'

(mailing address)

WELL LOCATION:

sec 30 T 5 N R 11 E
8 miles SE of Dundre
(distance) (direction) (nearest town)

WELL PURPOSE: irrigation
(home, irrigation, municipal, industrial)

WELL COMPLETION DATA:

- (1) diameter (inches) 12"
- (2) total depth (feet) 97
- (3) static water level (feet) 14" below top of ground.
- (4) casing 12" (material) 57' (depth)
- 12" (size) If telescope see back.
- (5) screen 40' (length) 57' (depth to top)
- 12" (size) STEEL (material)
- (6) pump 40 (HP) 2400 (yield gpm)
- DIESEL (type power)
- (7) electric log NO (yes or no)

(organization running log)

(8) how well bottom plugged Steel Plate

DRILLERS REMARKS:

DEPT. OF NATURAL RESOURCES
BUREAU OF LAND & WATER RESOURCES


OCT - 7 1980

RECEIVED

May be 11 W 75

If well telescopes please sketch and show depths.

GROUND LEVEL

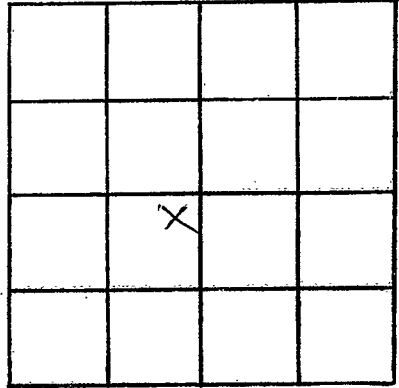

SECTION _____

Please indicate well location X.

ADDITIONAL INFORMATION

If more than one screen,
show locations of each on sketch.