

TUNICA  
N 21  
4-2-81

MISSISSIPPI  
BOARD OF WATER COMMISSIONERS  
416 North State Street  
Jackson, Mississippi 39201

CODED

WATER WELL DRILLERS LOG

4-2-81 19 Hester Drilling Jackson  
date well completed firm name county well located

LANDOWNER: J E Workman  
Rt #2 Sledge,  
Miss  
(mailing address)

Description of formations encountered	from	to
Clay	0	42
fine sand	42	58
course sand	58	103
Gravel		

WELL LOCATION:  
sec. 14 T. 7 N. R. 11 E  
5 1/2 miles West of Sledge  
(distance) (direction) (nearest town)

CODED

WELL PURPOSE: Drinking  
(home, irrigation, municipal, industrial)

- WELL COMPLETION DATA:
- (1) diameter (inches) 8
  - (2) total depth (feet) 103
  - (3) static water level (feet) 10 below top of ground.
  - (4) casing Plastic 63  
(material) (depth)
  - no if telescope see back.  
(size)
  - (5) screen 40 63  
(length) (depth to top)
  - 8 plastic  
(size) (material)
  - (6) pump 15 hp 1100  
(HP) (yield gpm)
  - Elect  
(type power)
  - (7) electric log no  
(yes or no)
  - no  
(organization running log)
  - (8) how well bottom plugged Plastic  
Cap

DEPT. OF NATURAL RESOURCES  
BUREAU OF LAND & WATER RESOURCES


MAY - 7 1981

RECEIVED

DRILLERS REMARKS: This  
Well had scattered  
formation + Balloned  
out on Rock.

If well telescopes please sketch and show depths.

GROUND LEVEL

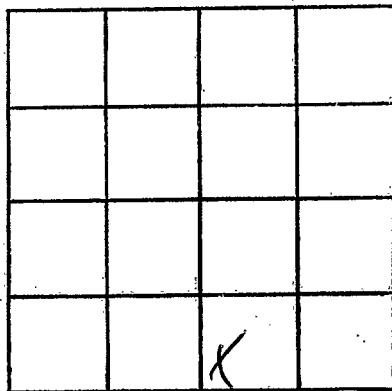

SECTION \_\_\_\_\_

Please indicate well location X.

ADDITIONAL INFORMATION

If more than one screen, show locations of each on sketch.