

TONICA
N 23
3-28-81

MISSISSIPPI
BOARD OF WATER COMMISSIONERS
416 North State Street
Jackson, Mississippi 39201

WATER WELL DRILLERS LICENSE

3-28-81 19 Hester R. Drilling
date well completed firm name

LANDOWNER: John W. Gordon
ON: Rt # 2, Sledge
Miss.
(mailing address)

description of formations encountered

<u>Gravelly + Clay</u>	<u>0</u>	<u>43</u>
<u>fine sand</u>	<u>43</u>	<u>51</u>
<u>Course Sand</u>	<u>51</u>	<u>103</u>
<u>+ gravel</u>		

WELL LOCATION:
sec. 20 T. 7 N. R. 11 E. S. 8
6 miles West of Sledge
(distance) (direction) (nearest town)

RODEN

WELL PURPOSE: Drinking
(home, irrigation, municipal, industrial)

WELL COMPLETION DATA:

(1) diameter (inches) 16"

(2) total depth (feet) 103

(3) static water level (feet) 12 below above top of ground.

(4) casing Steel, 103
(material) (depth)

(size) If telescope see back.

(5) screen 40#, 103
(length) (depth to top)

16, Steel
(size) (material)

(6) pump 50, 2000
(HP) (yield gpm)

Elect
(type power)

(7) electric log no
(yes or no)

no
(organization running log)


(8) how well bottom plugged steel plate

DEPT. OF NATURAL RESOURCES
BUREAU OF LAND & WATER RESOURCES

MAY - 7 1981

RECEIVED

DRILLERS REMARKS:
Real good formation

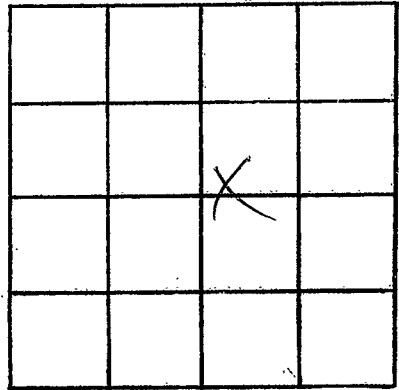

SECTION _____

Please indicate well location X.

ADDITIONAL INFORMATION

If more than one screen,
show locations of each on sketch.