

Union
A 6
4-17-70

MISSISSIPPI
BOARD OF WATER COMMISSIONERS
416 North State Street
Jackson, Mississippi 39201

CODED

WATER WELL DRILLERS LOG

4-17-70 date well completed
J.T. Medler firm name
UNION county well located

LANDOWNER: PINK SHAW
H.W. 78 West of New Albany
New Albany Miss
(mailing address)

description of formations encountered	from to	
Red clay	0	8
White "	8	17
Blue "	17	27
Blue & white clay	27	34
Red sand	34	61
Blue " & Blue "	67	163
Blue "	163	448
Rock	448	460
Blue "	460	475
Rock	475	490
Sand	490	520
Rock	520	527
Blue "	527	549
Rock	549	551
Sand	551	576
Blue "	576	582

WELL LOCATION:
sec. 6 T. 6 N. R. 1 E. 216
4 miles west of Myrtle
(distance) (direction) (nearest town)

WELL PURPOSE:
(home, irrigation, municipal, industrial)

- WELL COMPLETION DATA:
- (1) diameter (inches) 4
 - (2) total depth (feet) 582
 - (3) static water level (feet) 160 below top of ground.
 - (4) casing P 195 (material) (depth)
(size) if telescope see back.
 - (5) screen (length) (depth to top)
(size) (material)
 - (6) pump 3/4 8 (HP) (yield gpm)
E. (type power)
 - (7) electric log (yes or no)
(organization running log)
 - (8) how well bottom plugged open

CODED


MAY 5 1970

DRILLERS REMARKS:

MISS. BD. OF
WATER COMM.

If well telescopes please sketch and show depths.

GROUND LEVEL

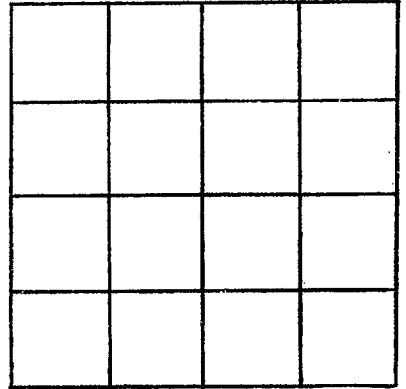

SECTION _____

Please indicate well location X.

ADDITIONAL INFORMATION

*I drill this for
James J. [unclear]
Well Drilling
Piquette, Mass*

If more than one screen,
show locations of each on sketch.