

Union
A 8
6-24-70

MISSISSIPPI
BOARD OF WATER COMMISSIONERS
416 North State Street
Jackson, Mississippi 39201

CODED

WATER WELL DRILLERS LOG

6-24 1970
date well completed

Ed Clark
firm name

Union
county well located

LANDOWNER:

J. L. Kitty
Route, Myrtle
(mailing address)

description of formations encountered

from to

Clay	0	30
Rock & Sand	30	170
Blue mud	170	270
Rock & Sand	270	528

WELL LOCATION:

sec. A T 60 S R 1 E
19 miles SE of New Albany
(distance) (direction) (nearest town)

WELL PURPOSE:

Home
(home, irrigation, municipal, industrial)

WELL COMPLETION DATA:

- (1) diameter (inches) 4"
- (2) total depth (feet) 528'
- (3) static water level (feet) 175' below top of ground.
- (4) casing metal, 174'
(material) (depth)
4" if telescope see back.
(size)
- (5) screen none
(length) (depth to top)
(size) (material)
- (6) pump 3/4 Red 6
(HP) (yield gpm)
Electric
(type power)
- (7) electric log no
(yes or no)
(organization running log)
- (8) how well bottom plugged no


CODED

JUL 1 1970

DRILLERS REMARKS:

If well telescopes please sketch and show depths.

GROUND LEVEL

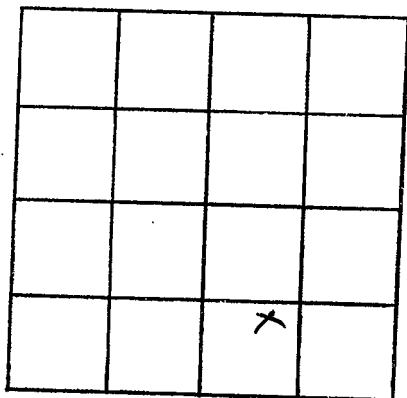

SECTION _____

Please indicate well location X.

ADDITIONAL INFORMATION

If more than one screen,
show locations of each on sketch.