

MISSISSIPPI
BOARD OF WATER COMMISSIONERS
416 North State Street
Jackson, Mississippi 39201

CODED

WATER WELL DRILLERS LOG

Union
A-10
9-1-71

Sept 1 1971 Ed Clark Co. Union
date well completed firm name county well located

LANDOWNER:

D. F. Azlin
Myrtle, Ft. one
(mailing address)

description of formations encountered

from to

Clay	0	30
Rock & Sand	30	110
Blue mud	110	470
Rock & Sand	470	550

WELL LOCATION:

sec 31 T 4 S R 1 E
1.5 miles SW of Myrtle
(distance) (direction) (nearest town)

WELL PURPOSE:

Home
(home, irrigation, municipal, industrial)

WELL COMPLETION DATA:

- (1) diameter (inches) 4"
- (2) total depth (feet) 550'
- (3) static water level (feet) 40' below top of ground.
- (4) casing metal, 140'
(material) (depth)
4" if telescope see back.
(size)
- (5) screen none
(length) (depth to top)
(size) (material)
- (6) pump 1/2 hp, 5
(HP) (yield gpm)
Electric
(type power)
- (7) electric log no
(yes or no)

CODED

(organization running log)

(8) how well bottom plugged no


DRILLERS REMARKS:

SEP 16 1971

MISS. BD. OF
WATER COM.

If well telescopes please sketch and show depths.

GROUND LEVEL

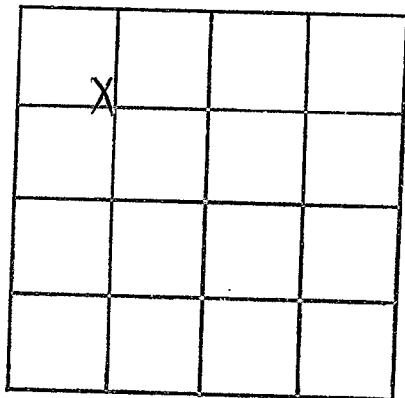

SECTION _____

Please indicate well location X.

ADDITIONAL INFORMATION

If more than one screen,
show locations of each on sketch.