

A14

5-15-62

WATER WELL DRILLERS LOG

Date: 5-15, 1962, Driller: Y. J. Mays **CODED** near _____
(Name)

(1) Owner of Land: J. J. Gray
(Name)
Myrtle R. D. 1
(Address)

(2) Location: 1/2 $\frac{1}{4}$, 1/4, Sec. 33 T1 R15
7 miles S W, of Myrtle
(distance) (direction) (Nearest Town)

(3) Topography: 1
(Hilly) (Flat) (Level)

(4) Purpose of Well: Domestic
(Domestic Irrigation
Municipal, Industrial, Other)

Description & Color of Materials Sand, Clay, Red Clay, Shell, etc.	Thick- ness Feet	Depth Feet
<u>silt & clay</u>	<u>20</u>	<u>20</u>
<u>Blue shale</u>	<u>340</u>	<u>360</u>
<u>rock</u>	<u>60</u>	<u>420</u>
<u>blue sand</u>	<u>0.0</u>	<u>420</u>
<u>rock & sand</u>	<u>40</u>	<u>460</u>
<u>Blue sand</u>	<u>150</u>	<u>610</u>
<u>rock & sand</u>	<u>71</u>	<u>681</u>

Information upon completion of well:

(1) Diameter 4 inches.

(2) Total Depth 481 feet.

(3) Water Level 27 1/2 feet below top of ground.


(4) Cased to 63, Size 4

(5) Screen: Size _____, Length _____

(6) Were any formations sealed against pollution?
_____ yes, _____ no.

CODED

If YES depth of formation _____
Why _____
Drillers Remarks: _____

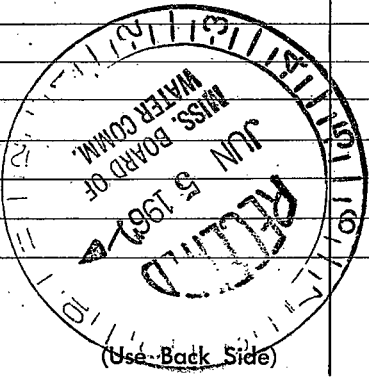

Well No. _____

miss

R-12 15 28/10/1944

28/10/1944
R-12-D

33 4 12
R-12-D

R-12-D

12
10
11
14
15